


NW 1/4 Sec 2 Twp 7 N R9 W

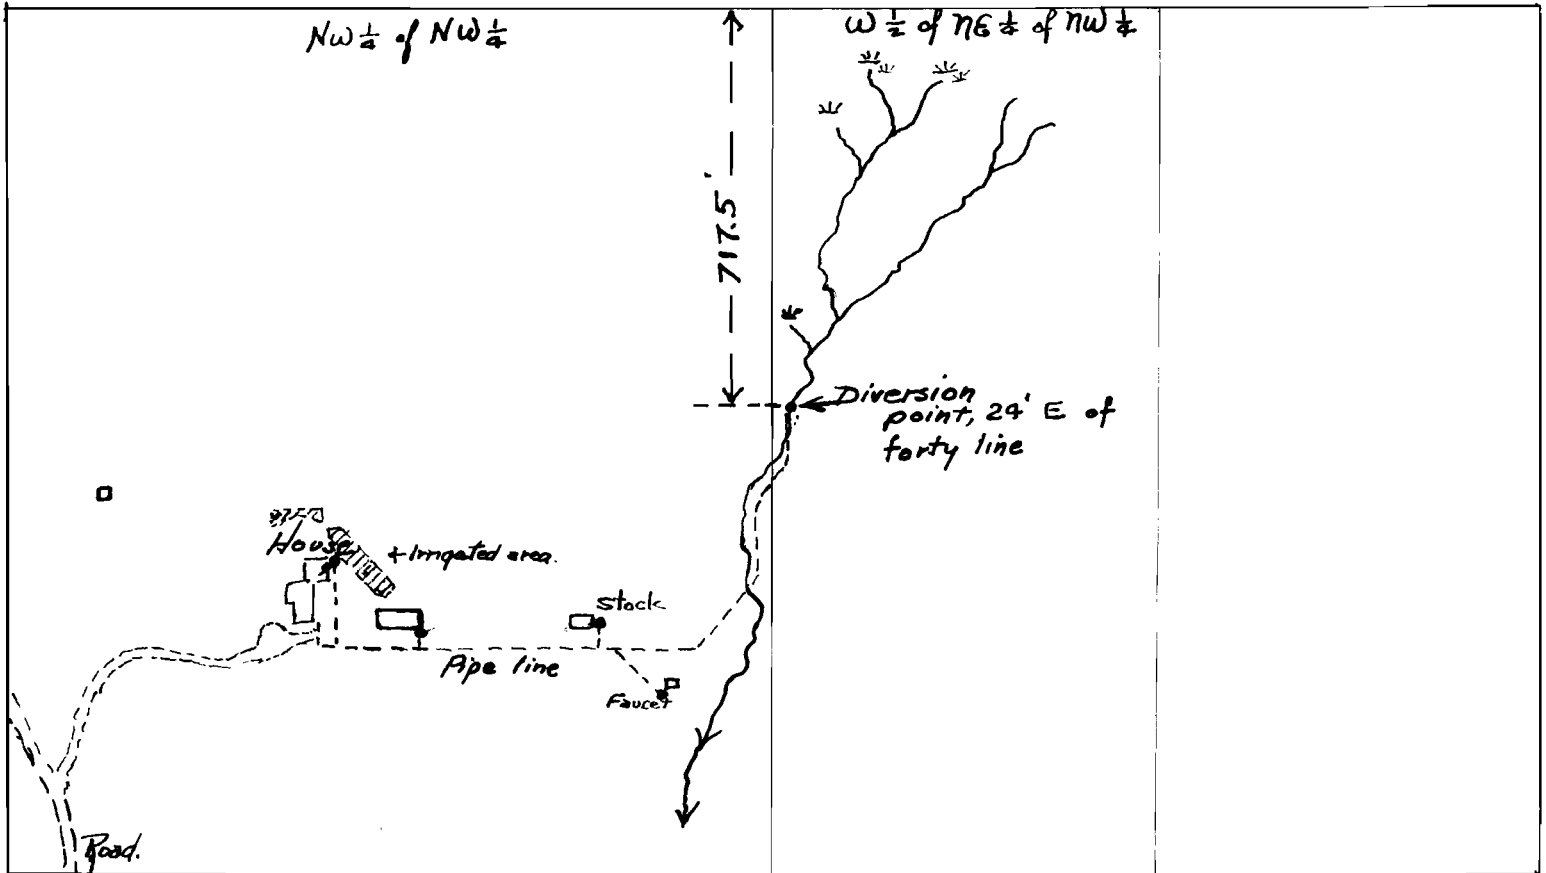

Application No. 29672  
Permit No. 23366

RECEIVED  
JAN 1 1955

H. A. Pearse  
Jan. 1, 1955