


RECEIVED  
JAN 19 1955  
STATE ENGINEER  

T. 38 S., R. 5 W., W. M.  
Scale 4" = 1 Mile Jan. 1955  
I. G. Naylor.

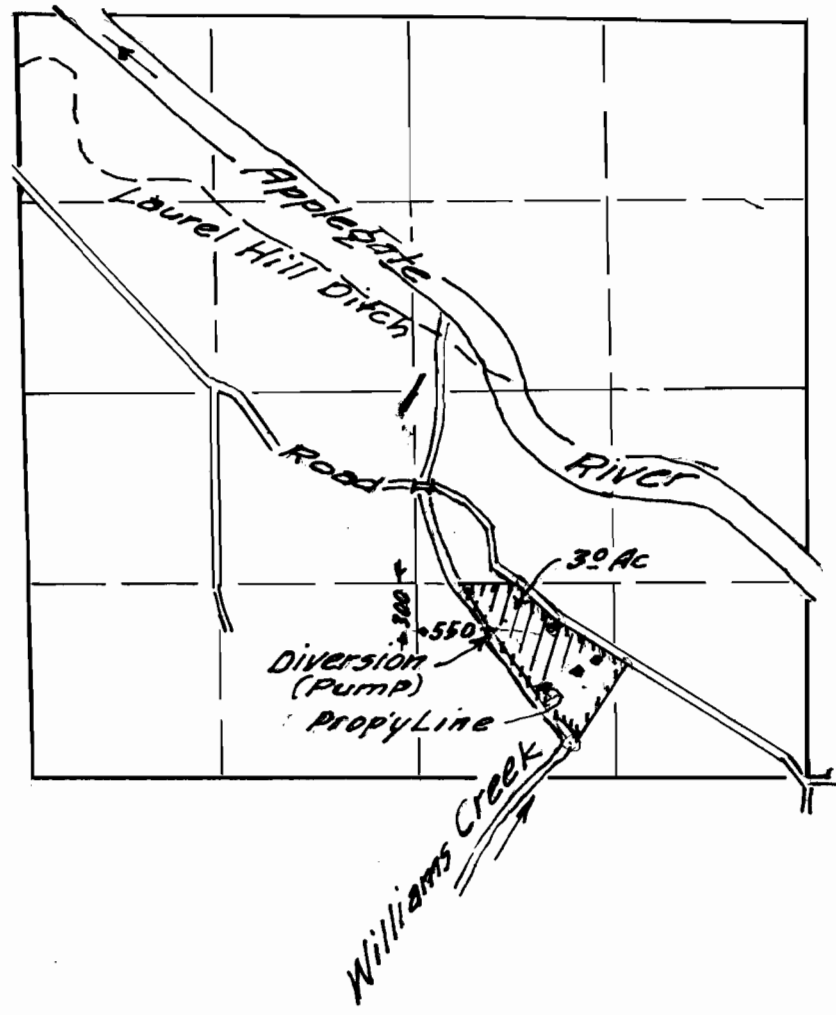

Application No 29699  
Permit No. 23884

29699