


T.40S.R.9W.W.M.

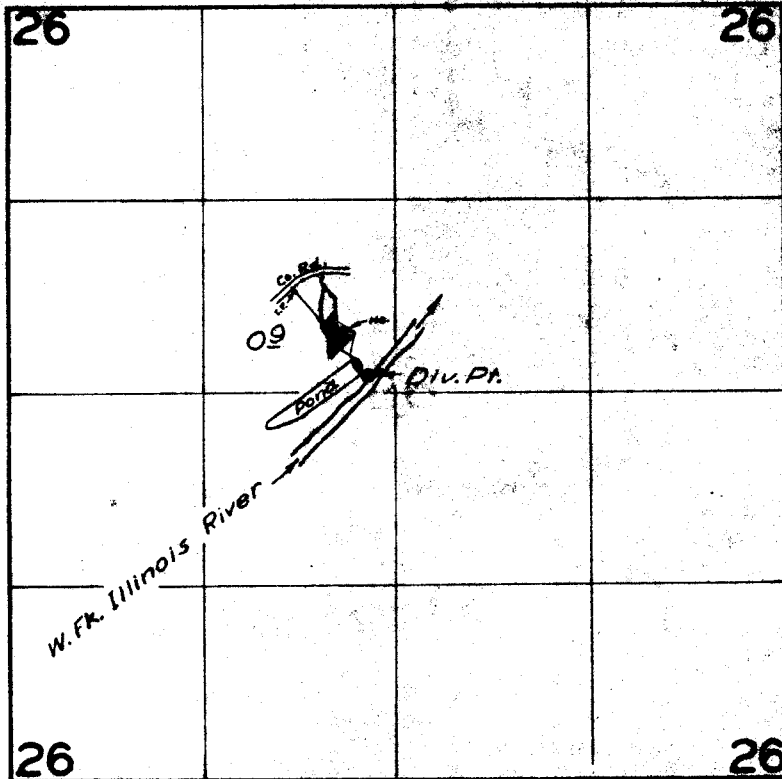

FINAL PROOF SURVEY UNDER

Application No. 29792 Permit No. 23452
IN NAME OF

MRS. HELEN A. BOTTEL

Surveyed 14 July 1959, by m. Bieh