


RECEIVED
APR 27 1955
STATE ENGINEER
SALEM, OREGON

RECEIVED
DEC 3 1954
STATE ENGINEER
SALEM, OREGON

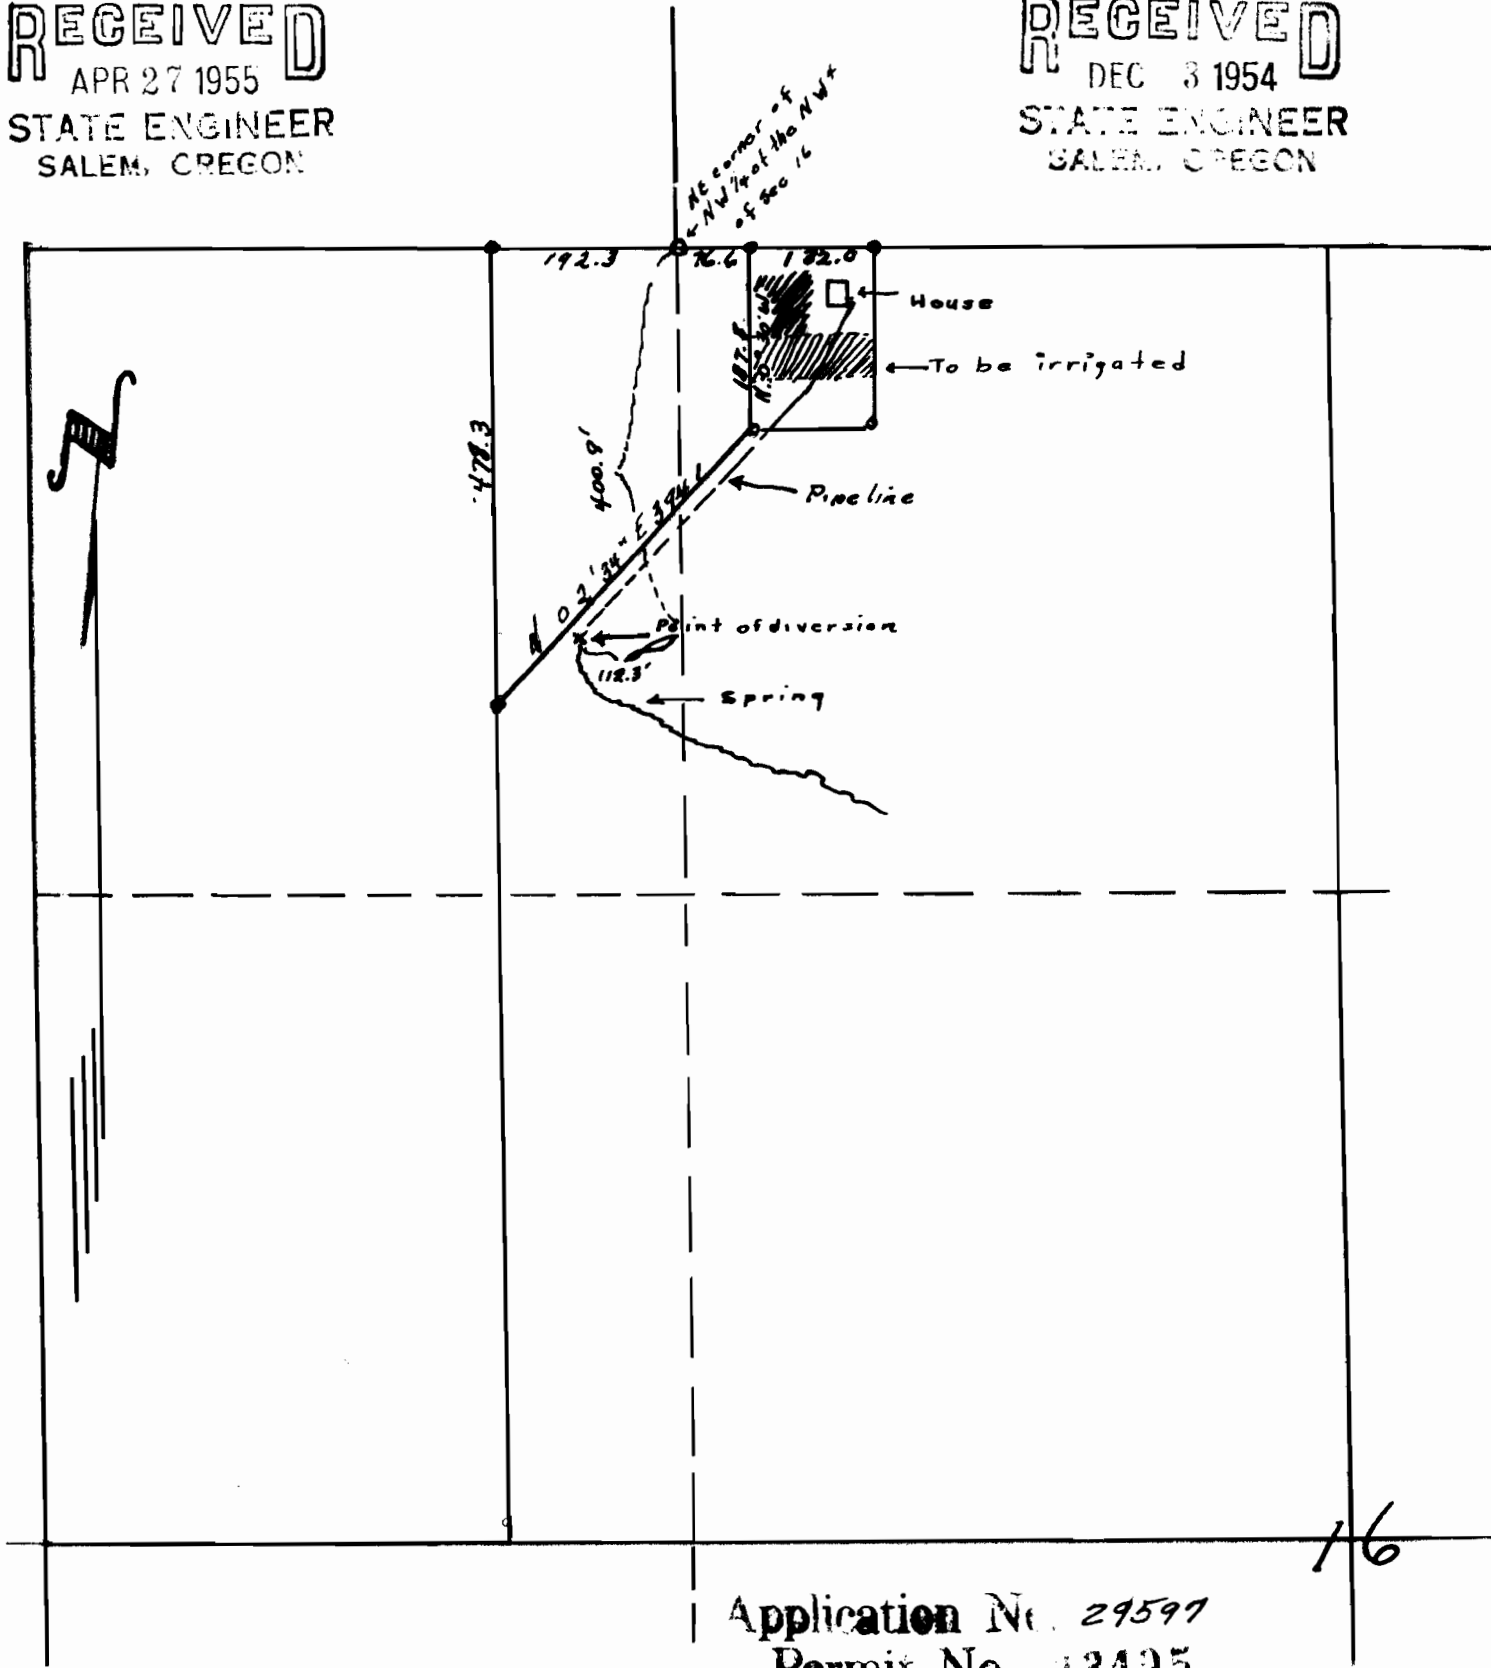

Application No. 29597


