


T.35S.R.6W.W.M.

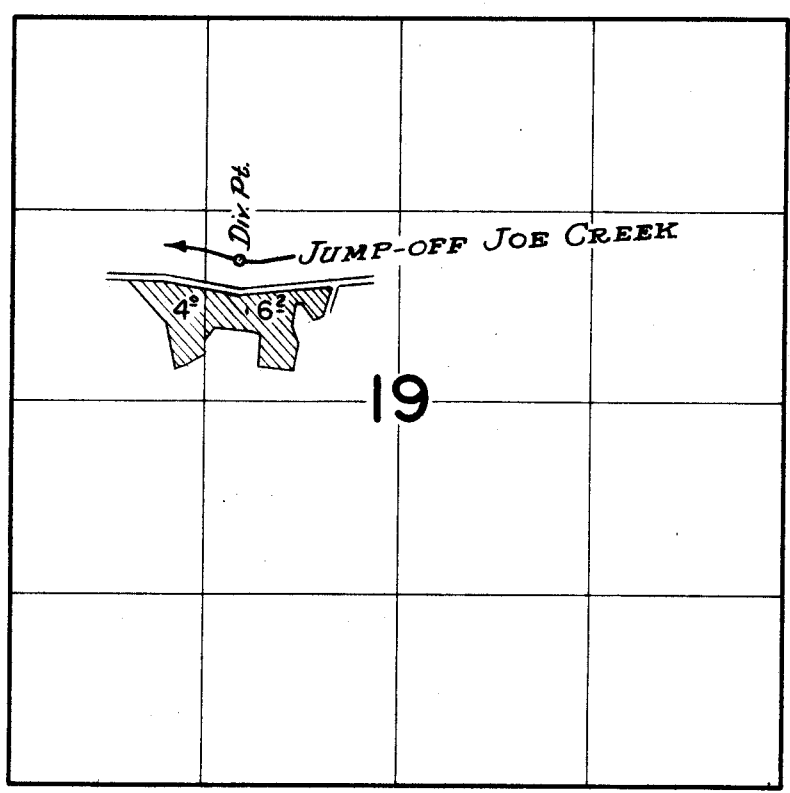

FINAL PROOF SURVEY UNDER

Application No. 29915... Permit No. 23549
IN NAME OF

GLADYS O. GIBSON

Surveyed Sept. 30. 1960, by R. Steimer