


T. 40 S., R's 8 and 9 W., W. M.
Scale 4" = 1 mile

May 1955

Rough & Ready Lbr. Co. by Lewis F. Krauss.

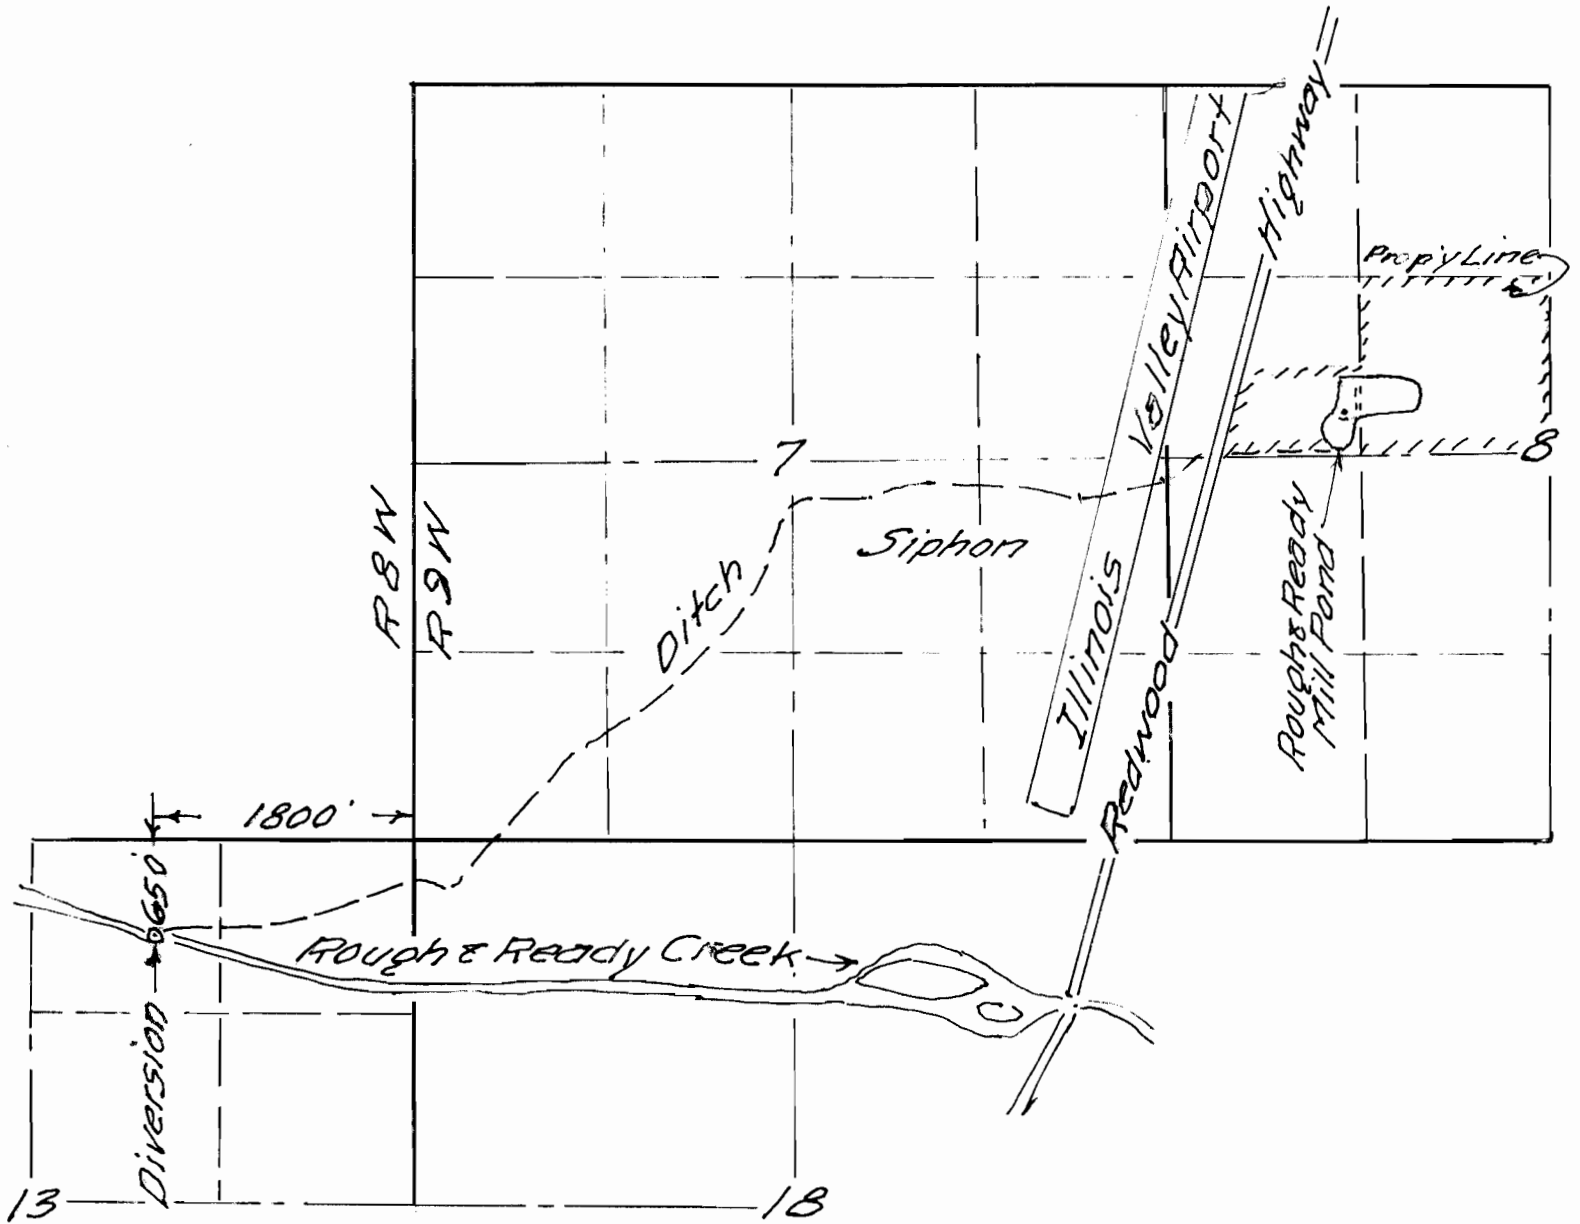

Application No. R-29970 & 29971
Permit No. R-1750 & 23609