


Sec. 28-165 R 2 E

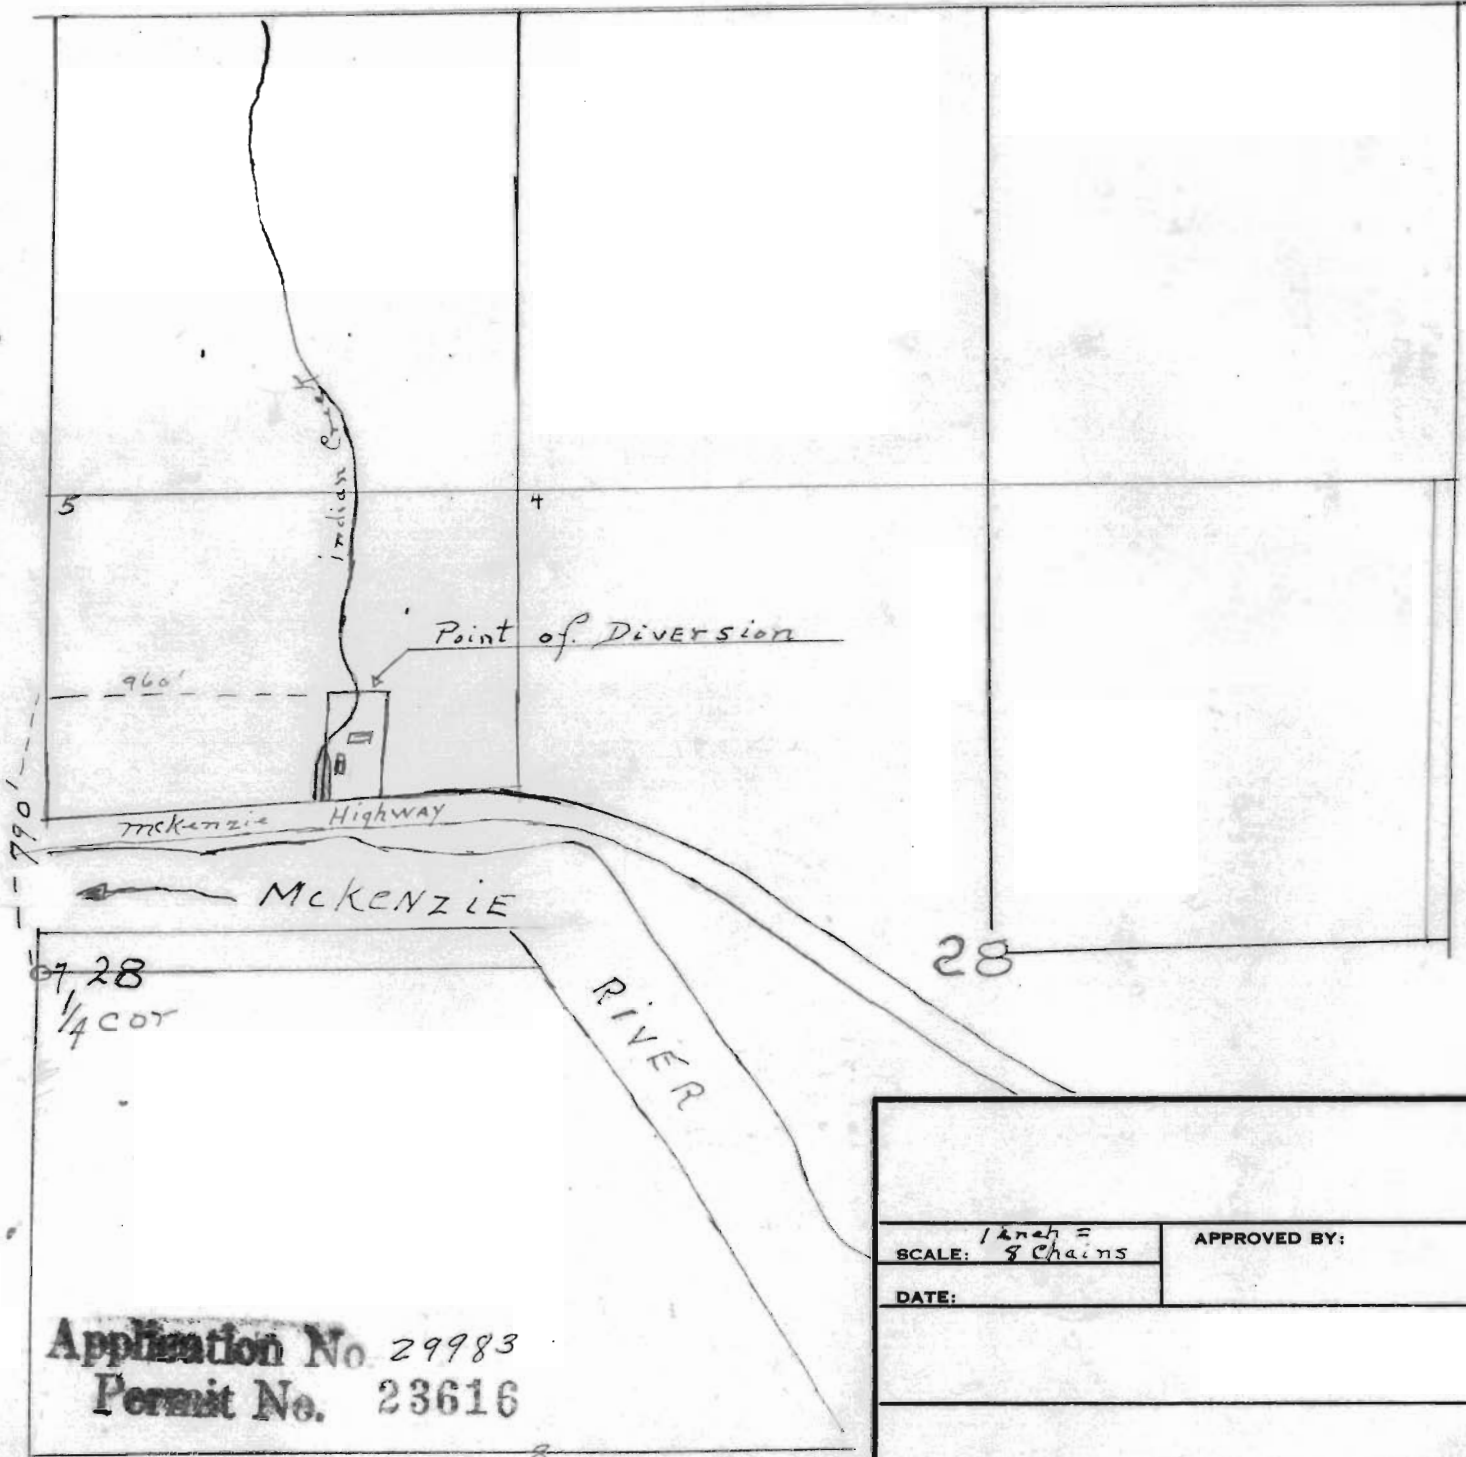

28
1/4 COR

28

29983

Application No. 29983
Permit No. 23616

SCALE: 1 inch = 8 Chains		APPROVED BY:	DRAWN BY
DATE:			REVISED
			DRAWING NUMBER