


Permit: S 23631  
Volume: 7  
Strm: BOARD SHANTY CR  
Trib: APPLGATE R  
Priority: 5/20/55

T.37S. R.5W.W.M.

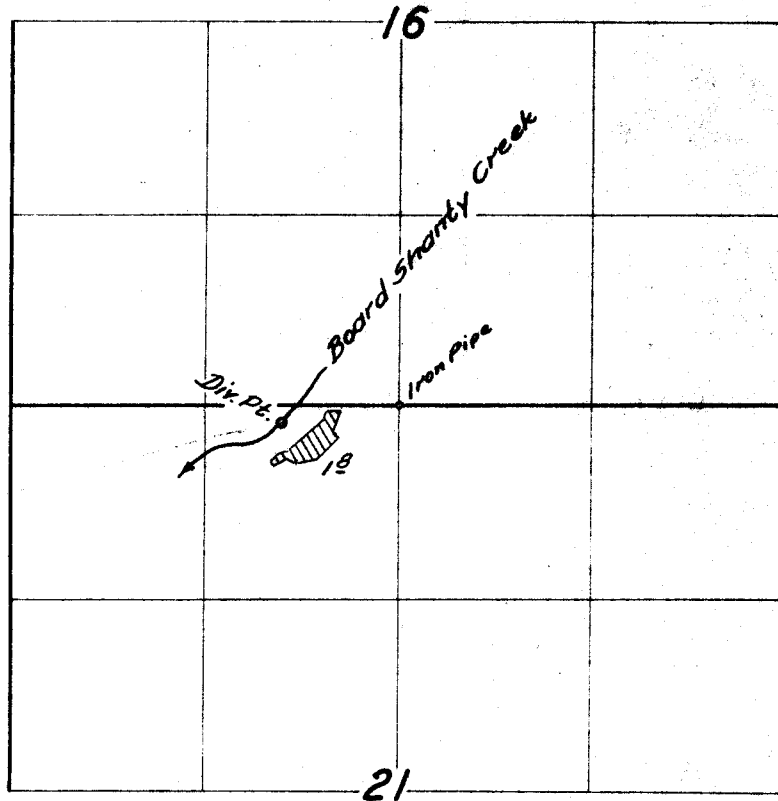

FIELD SURVEY  
U.S.G.S.  
NO. 30006 PERMIT NO. 23631  
IN NAME OF  
Alvin L. & Dorothy L. Anderson  
Surveyed July 24 1959 by COBENT

1852-V