

Permit: S 23632  
Volume: 5  
Strm: BANKS SPR  
Trib: QUARTZ CR  
Priority: 5/23/55

35-6-17

*See Final  
Proof*


*Approved  
4-2-55*

T.35 S., R.6 W. W.M.

Scale 4" = 1 mile

May 1955

Wesley Banks

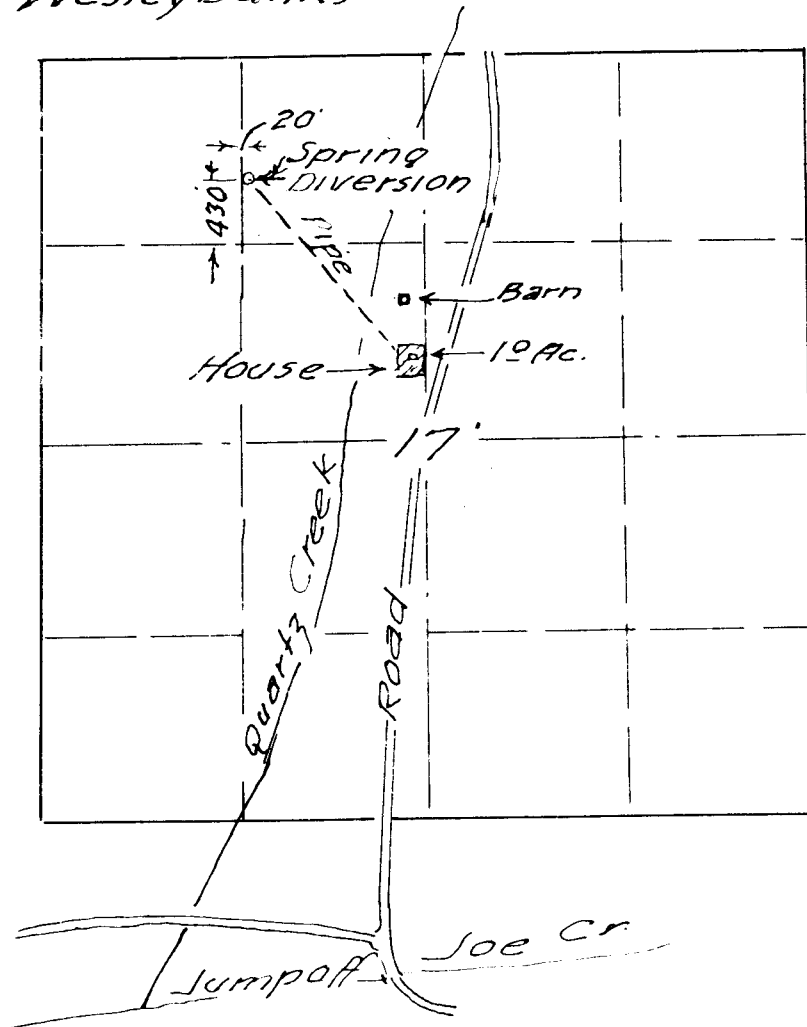

30008