


T.34-35S.R.5W.W.M.

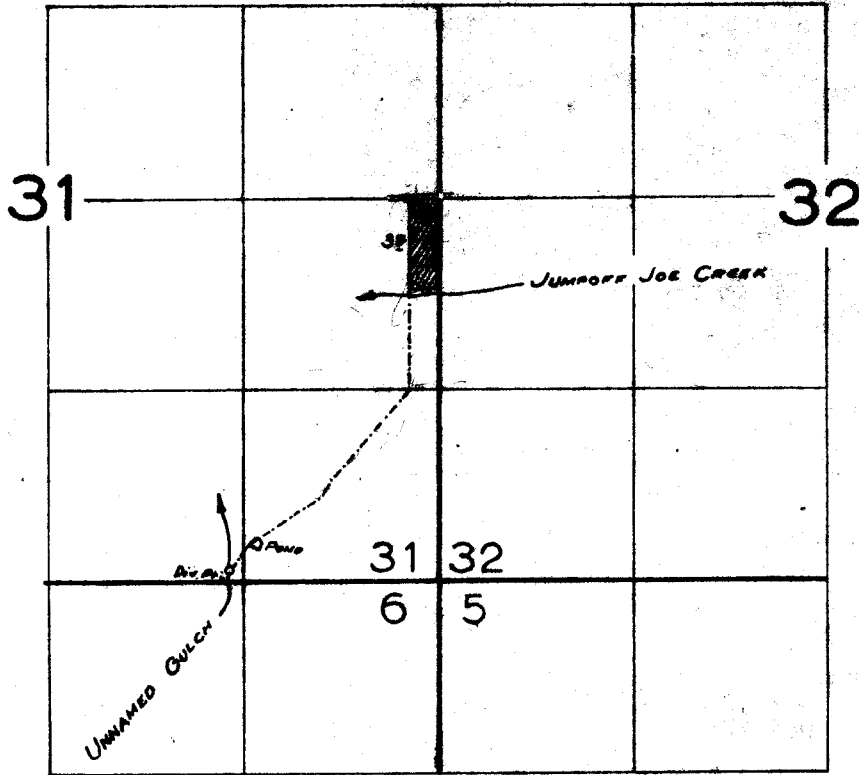

See TR 5129
 Ch Pl 158
 of creek

FINAL PROOF SURVEY UNDER

Application No. 30047 Permit No. 2369.2
 IN NAME OF

CARL HUSEN

Surveyed July 16, 1959, by *R. Jackson*