


T. 35S. R. 5W. W.M.

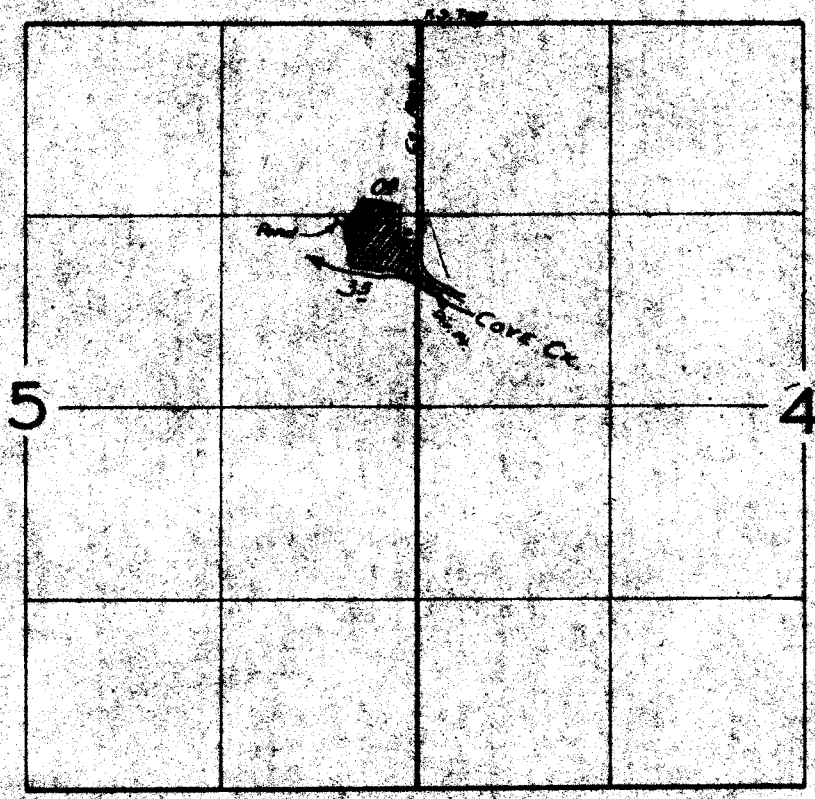

FINAL PROOF SURVEY
UNDER

Application No. 30070 Permit No. 23700
IN NAME OF

JOSEPH E. POLLOCK

Surveyed July 25, 1959, by *R. Jackson*