


T. 39S. R. 5W. W.M.

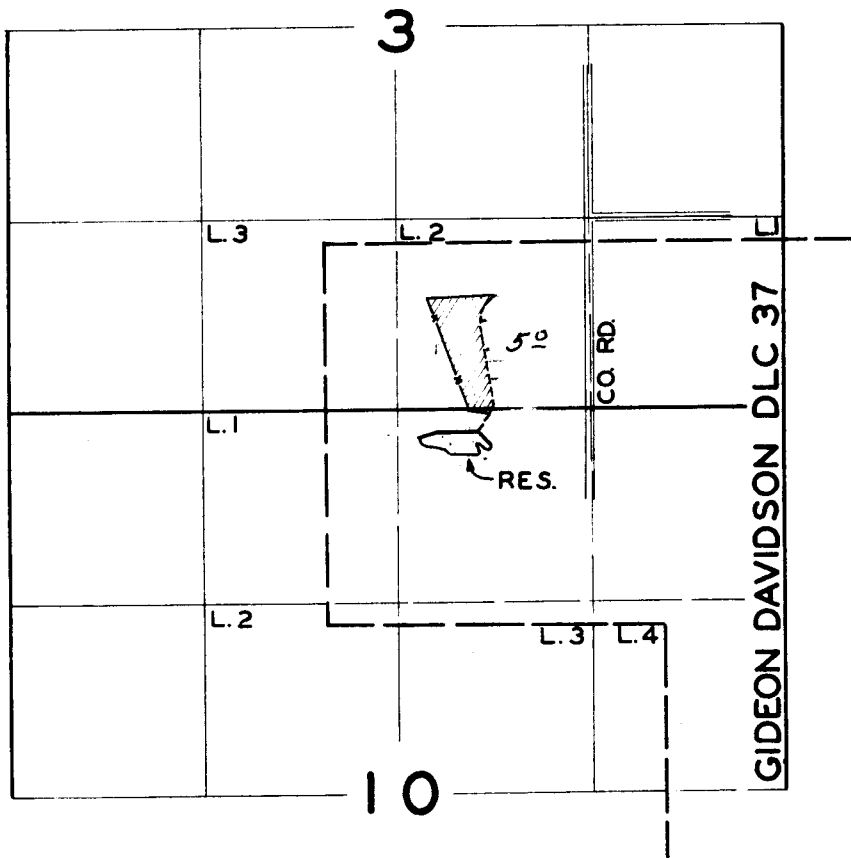

FINAL PROOF SURVEY UNDER

Application No. ^{R30119} 30120 Permit No. ^{R1782} 23772
 IN NAME OF

VIRGIL & KAY BERRY

Surveyed APRIL 14 1961, by R. D. STEIMER