


CHARLES BURK

SEC. 29, T. 12 S., R. 1 W., W.M., LINN CO., ORE.

Scale: 1" = 10 Chains

June 28, 1955

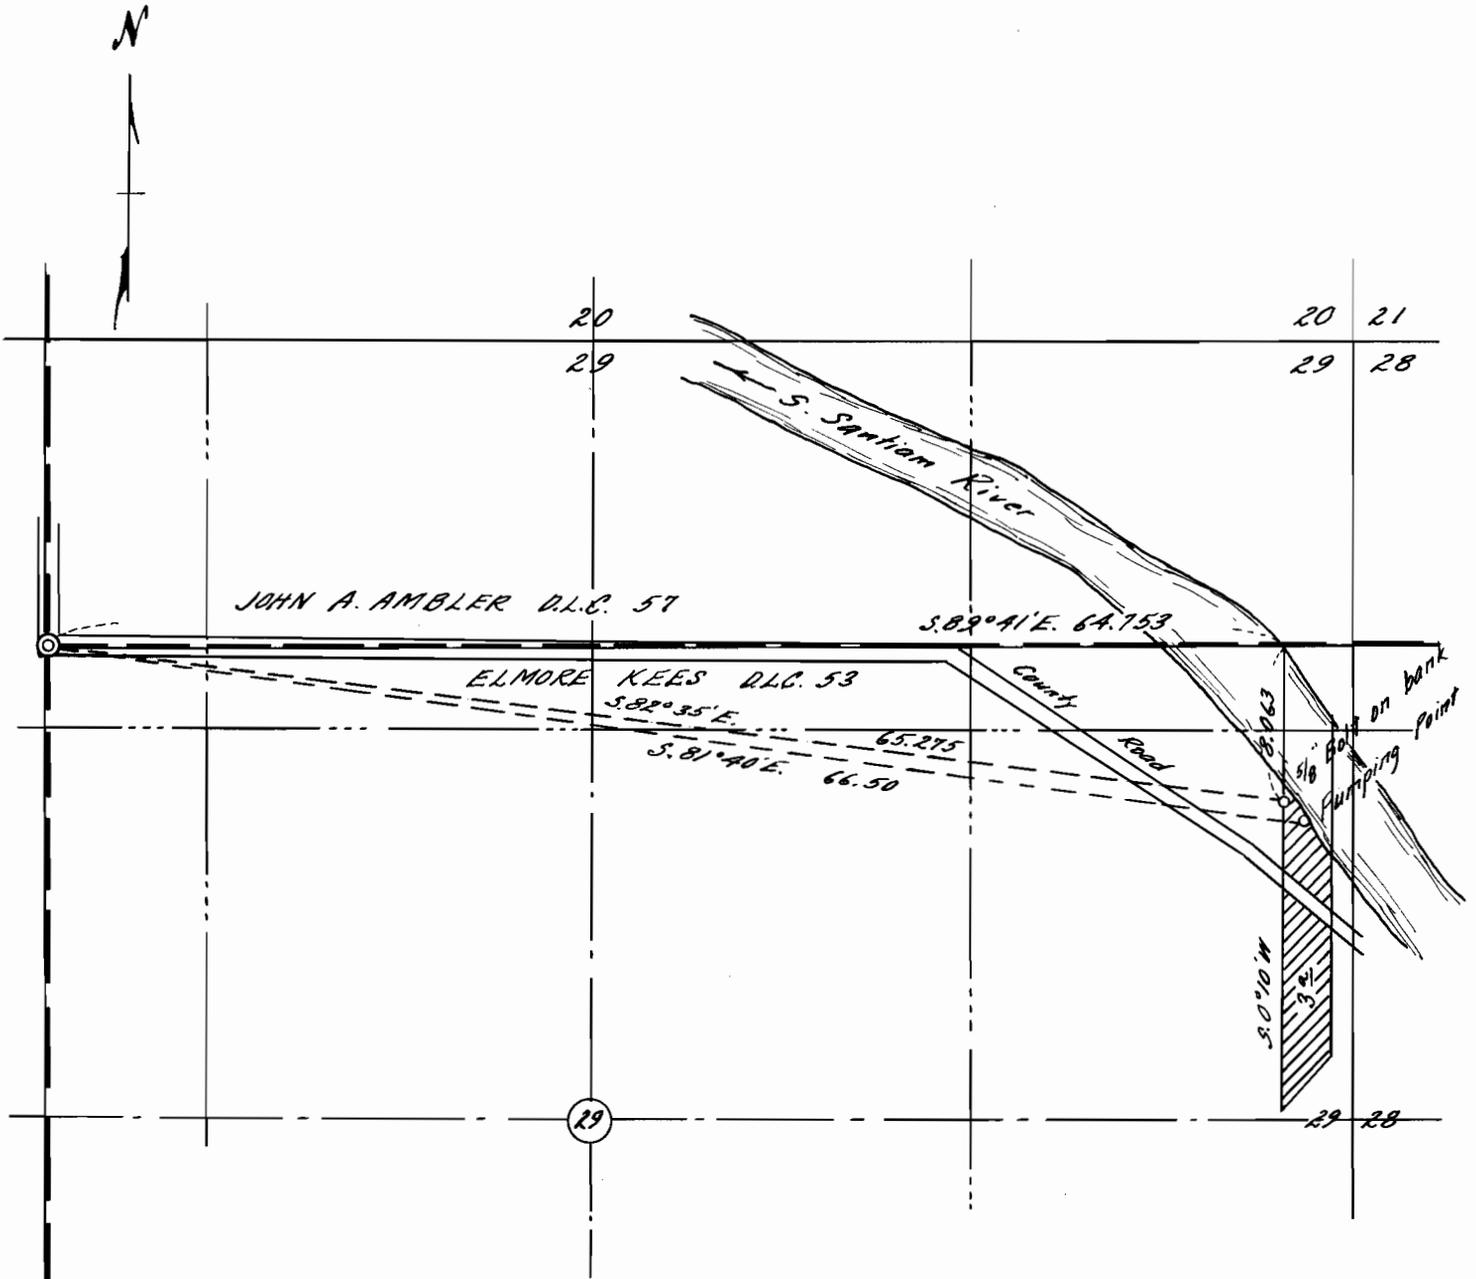

I, Orris A. Carnegie of Albany, Oregon do hereby certify that this map was made from notes taken during an actual survey made by me on June 1, 1948 and supplemented by information taken from the latest aerial photographs; that the monument shown on this map consisting of a 5/8" iron bolt is S. 82° 35' E. 65.275 chains from the Northwest corner of the Elmore Kees D.L.C. 53 in T. 12 S., R. 1 W. of the Will. Mer. in Linn County, Oregon.

REGISTERED
OREGON
LAND SURVEYOR

Orris A. Carnegie

MAY 9, 1947
ORRIS A. CARNEGIE
213

Application No 30149

Permit No 23788

30149