


T. 40 S., R. 3 W., W. M.

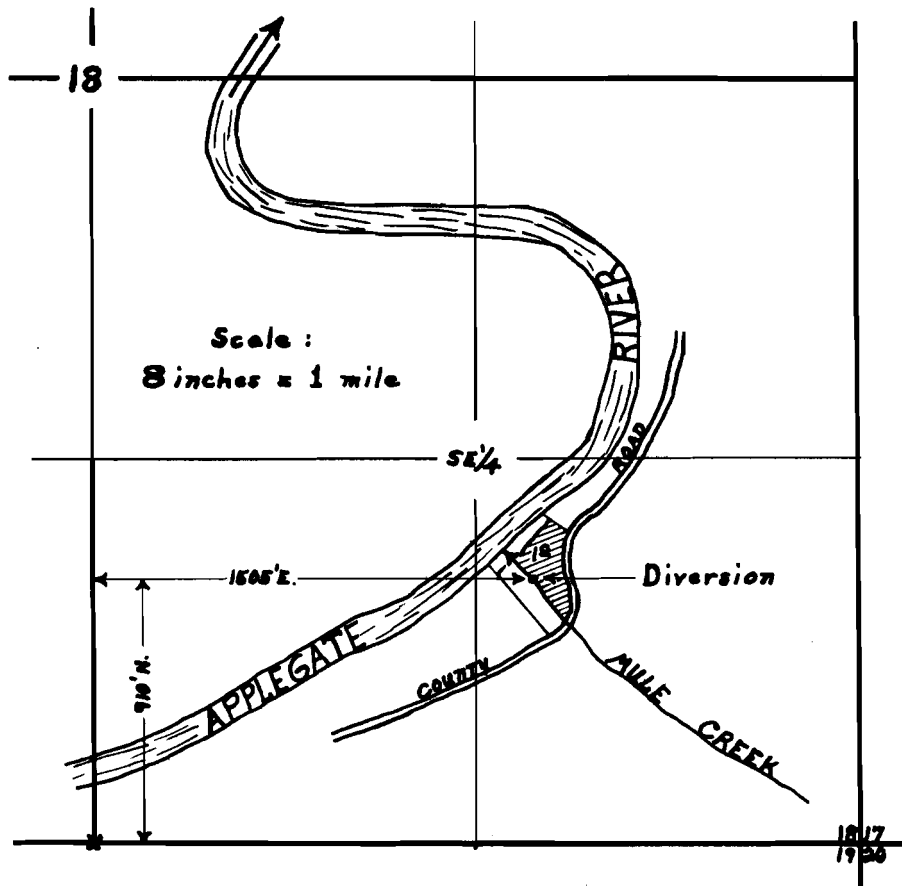

Map to accompany application of  
Hugh L. Scovell, for use of water  
from Mule Creek for Irrigation  
purposes.

This Office - October 6, 1955

David C. Hendrix, Watermaster

Application No. 30347

Permit No. 23871

30347