


T. 33 S., R. 6 W., W. M.
Scale 100' = 1" Oct. 1955
Mrs. Ben F. Whaley

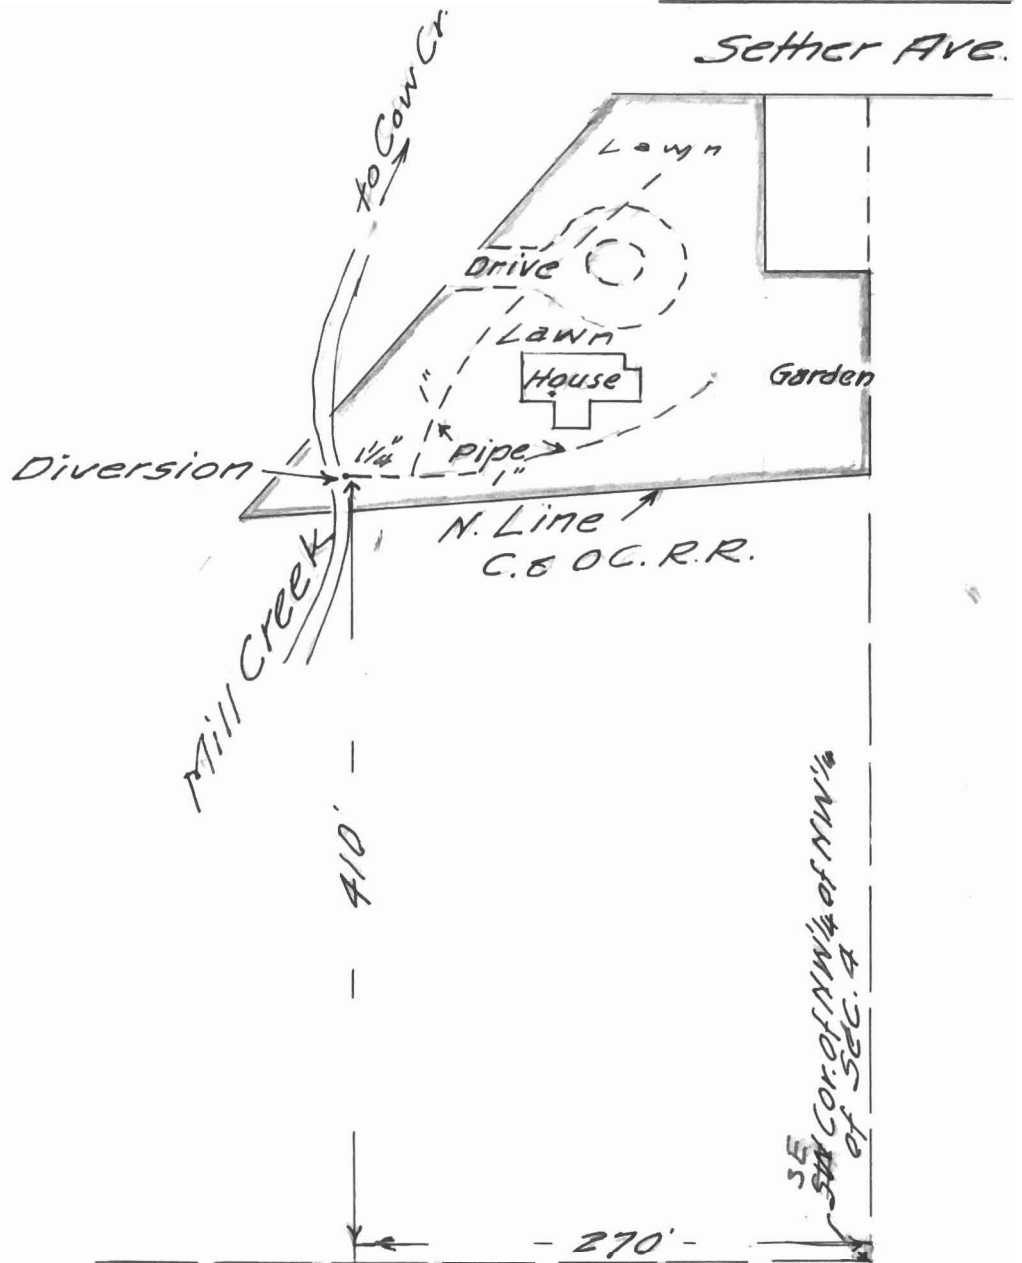

Application No. 30377
Permit No. 23878