


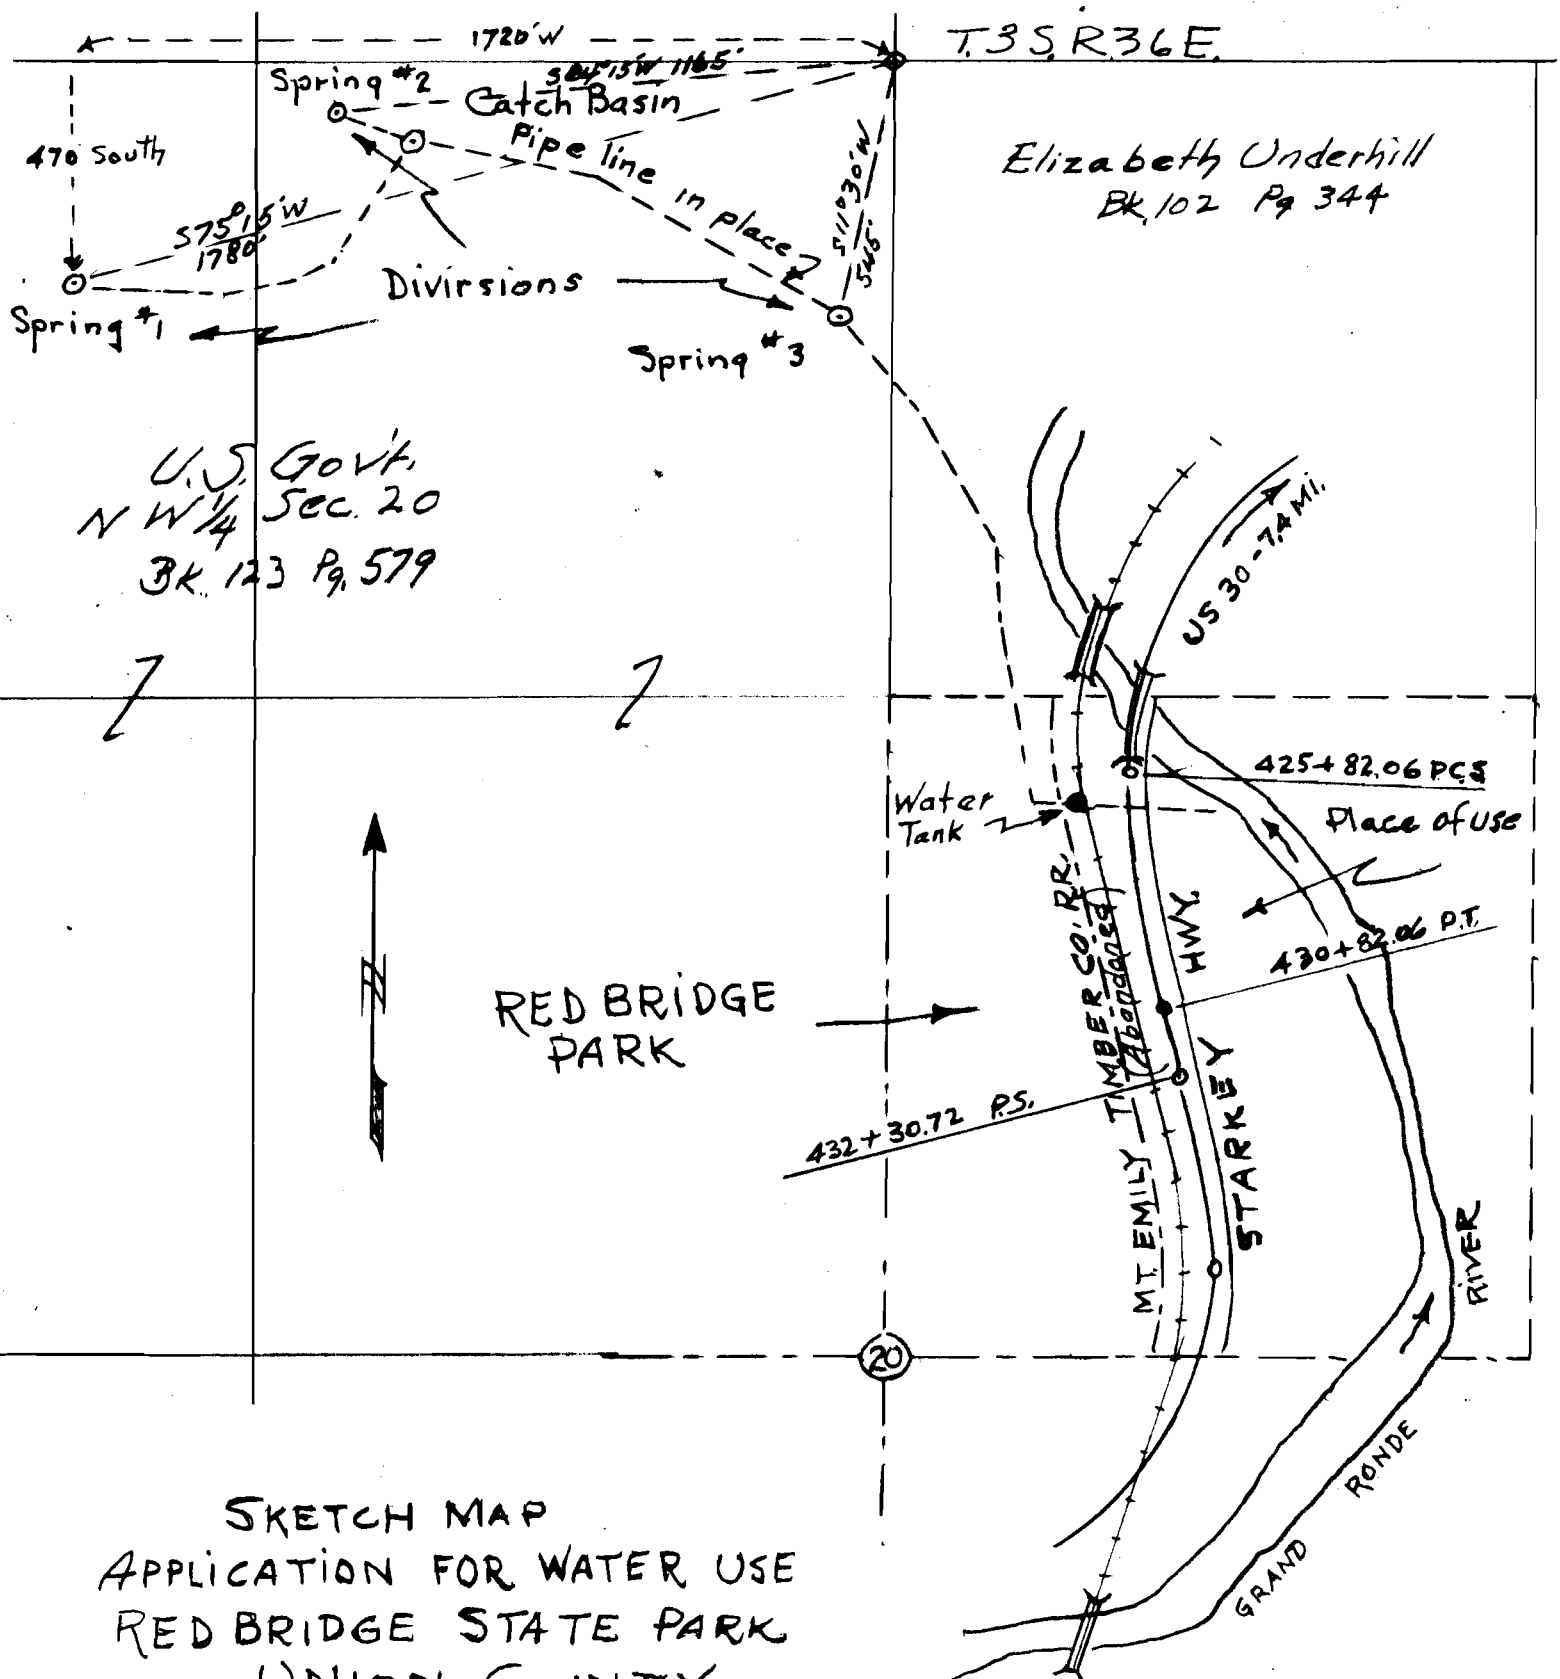

Application No. 30586
Permit No. 23884

RECEIVED
OCT 24 1955
STATE ENGINEER
