


T.36S. R.5W. W.M.

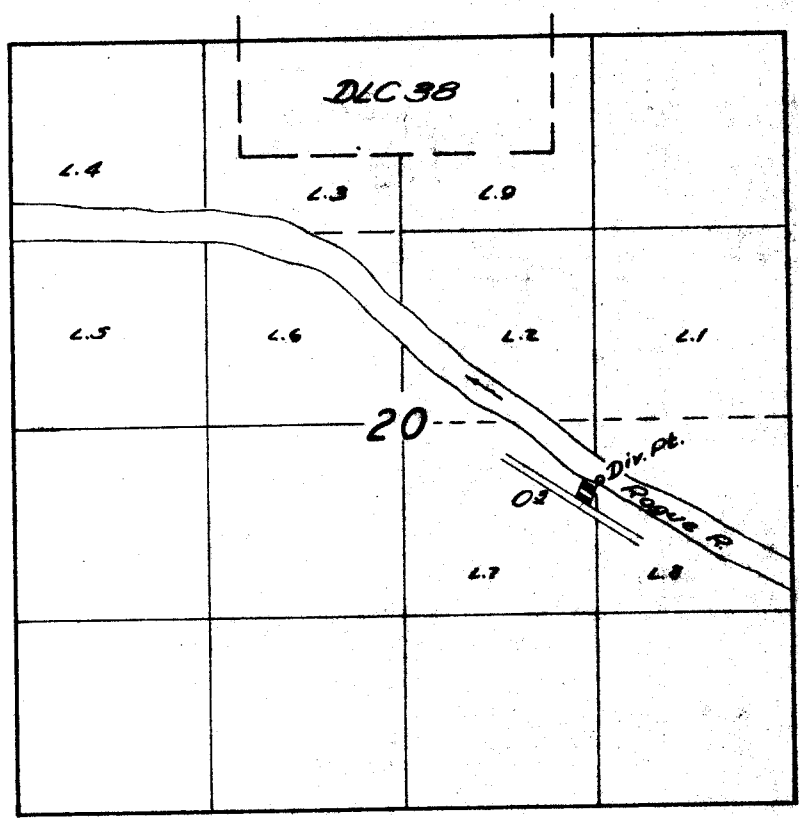

FINAL PROOF SURVEY

UNDER

Application No. 50496 Permit No. 23908

IN NAME OF

Mildred E. Wilbur

Surveyed July 14, 1950, by C. O. Burt

C. O. Burt