
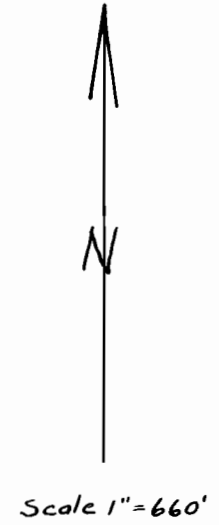


RECEIVED

STATE ENGINEER
SALEM, OREGON

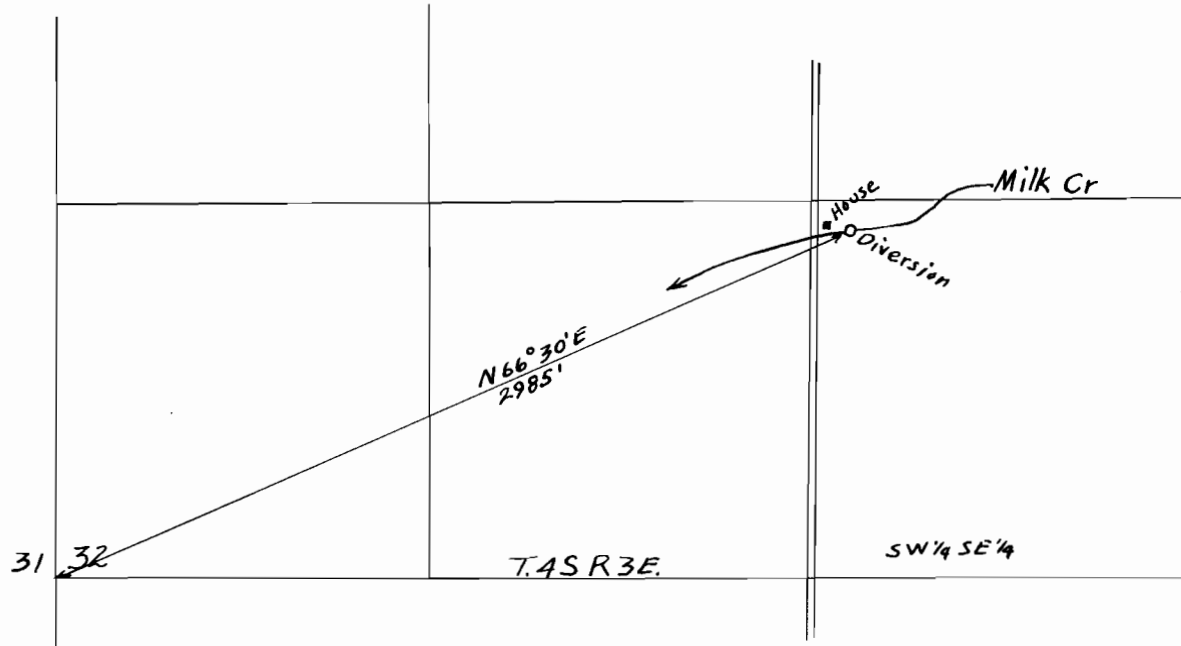

Application No. 30485
Permit No. 24010