37-6-23+
24

T.37S.R.6W.W.M.

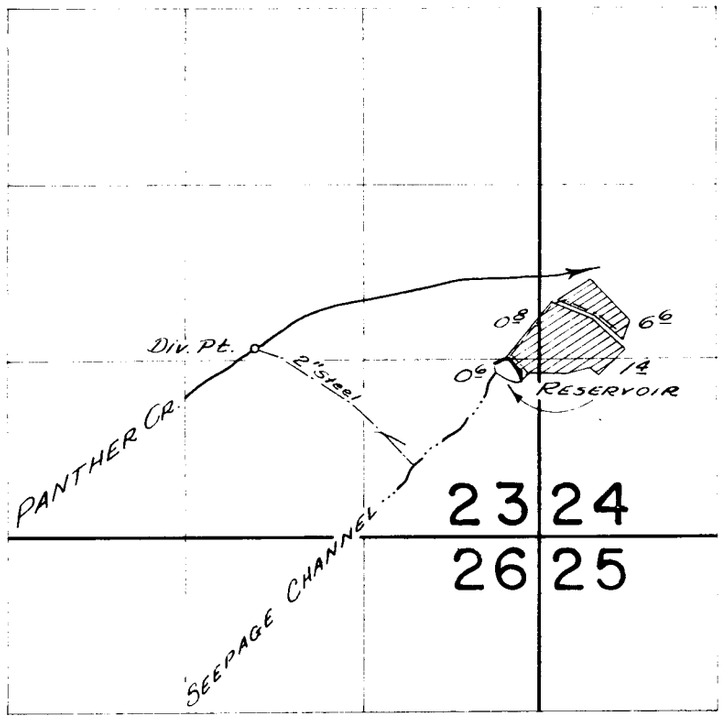

FINAL PROOF SURVEY
UNDER

Application No. R-30500 30501 Permit No. R-1827 24019
IN NAME OF

VIVIAN M. REINHARDT

Surveyed APRIL 11 1961, by C.Q. Bartels

1961-Y