


T.38 S.R.5 W.W.M.

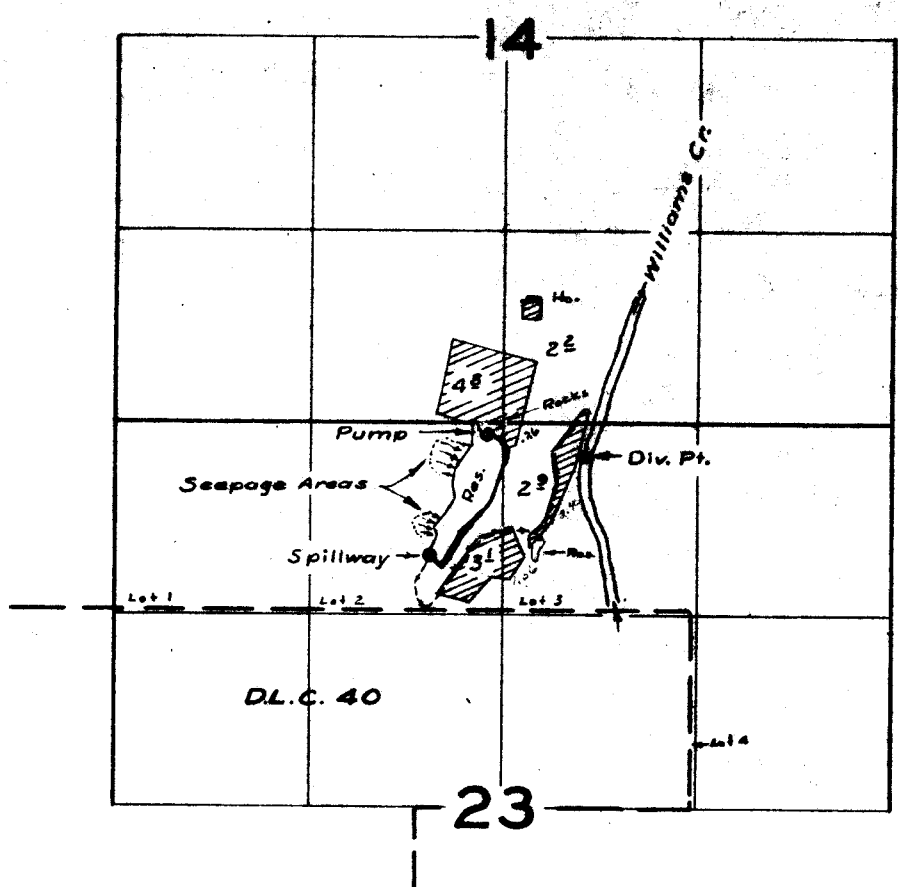

FINAL PROOF SURVEY UNDER

R-30521 *R-1829*
 Application No. *30522* Permit No. *24032*
 IN NAME OF

NORMAN WEBB

Surveyed *24 July 1959*, by *m. Bish*