


# T. 34 S. R. 6 W. W. M.

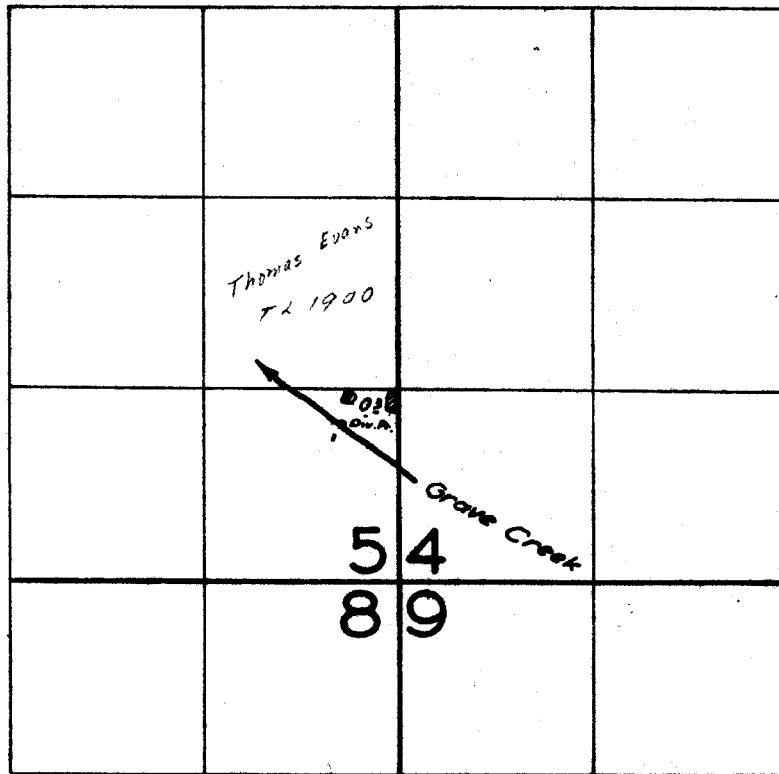

## FINAL PROOF SURVEY UNDER

Application No. 30543 Permit No. 24048  
IN NAME OF

*ORIN C. BROKAW, JR.*

Surveyed July 14 1959, by *R. Jackson*