


T. 10 & 11 S. R. 26 E. W. W.

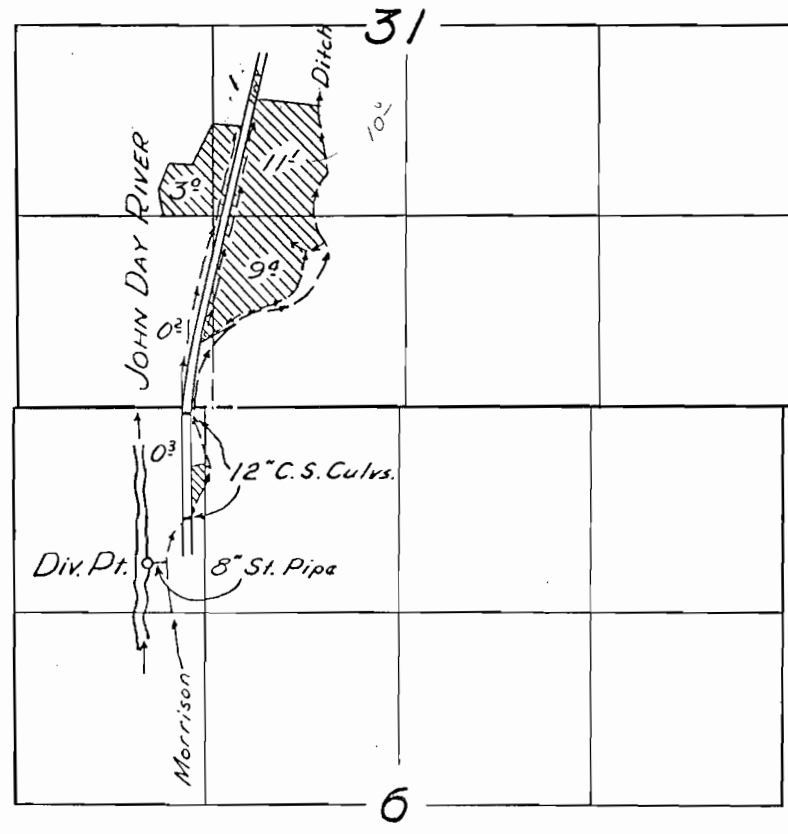

FINAL PROOF SURVEY

UNDER

Application No. 30530 Permit No. 24073

IN NAME OF

W. J. FOREE

Surveyed 27 Oct 1956, by C. A. Whitby