


T.36S.R.5W.W.M.

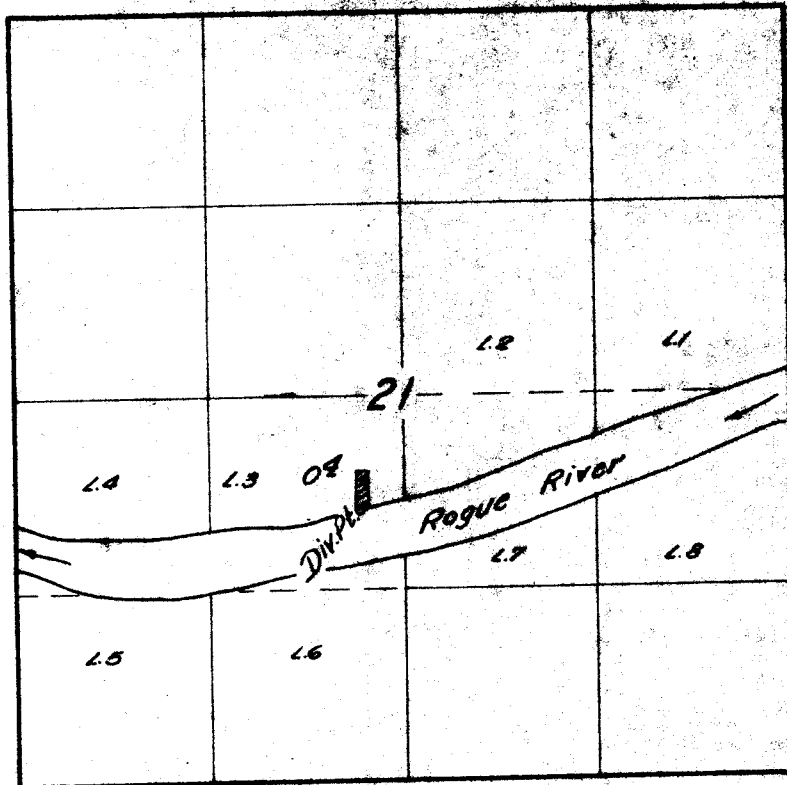

# FINAL PROOF SURVEY

UNDER

Application No. 30606 Permit No. 2416

IN NAME OF

Mrs. Truman E. Donaldson

Surveyed July 14, 1959, by C. B. Bartlett

1259-1