

W.R. 332


PLAGMANN FARMS

SECS. 32 & 33, T. 10 S., R. 2 W.

SECS. 4 & 5. T. 11 S., R. 2 W.


LINN COUNTY, OREGON

Scale: 1" = 10 Chains February 7, 1956

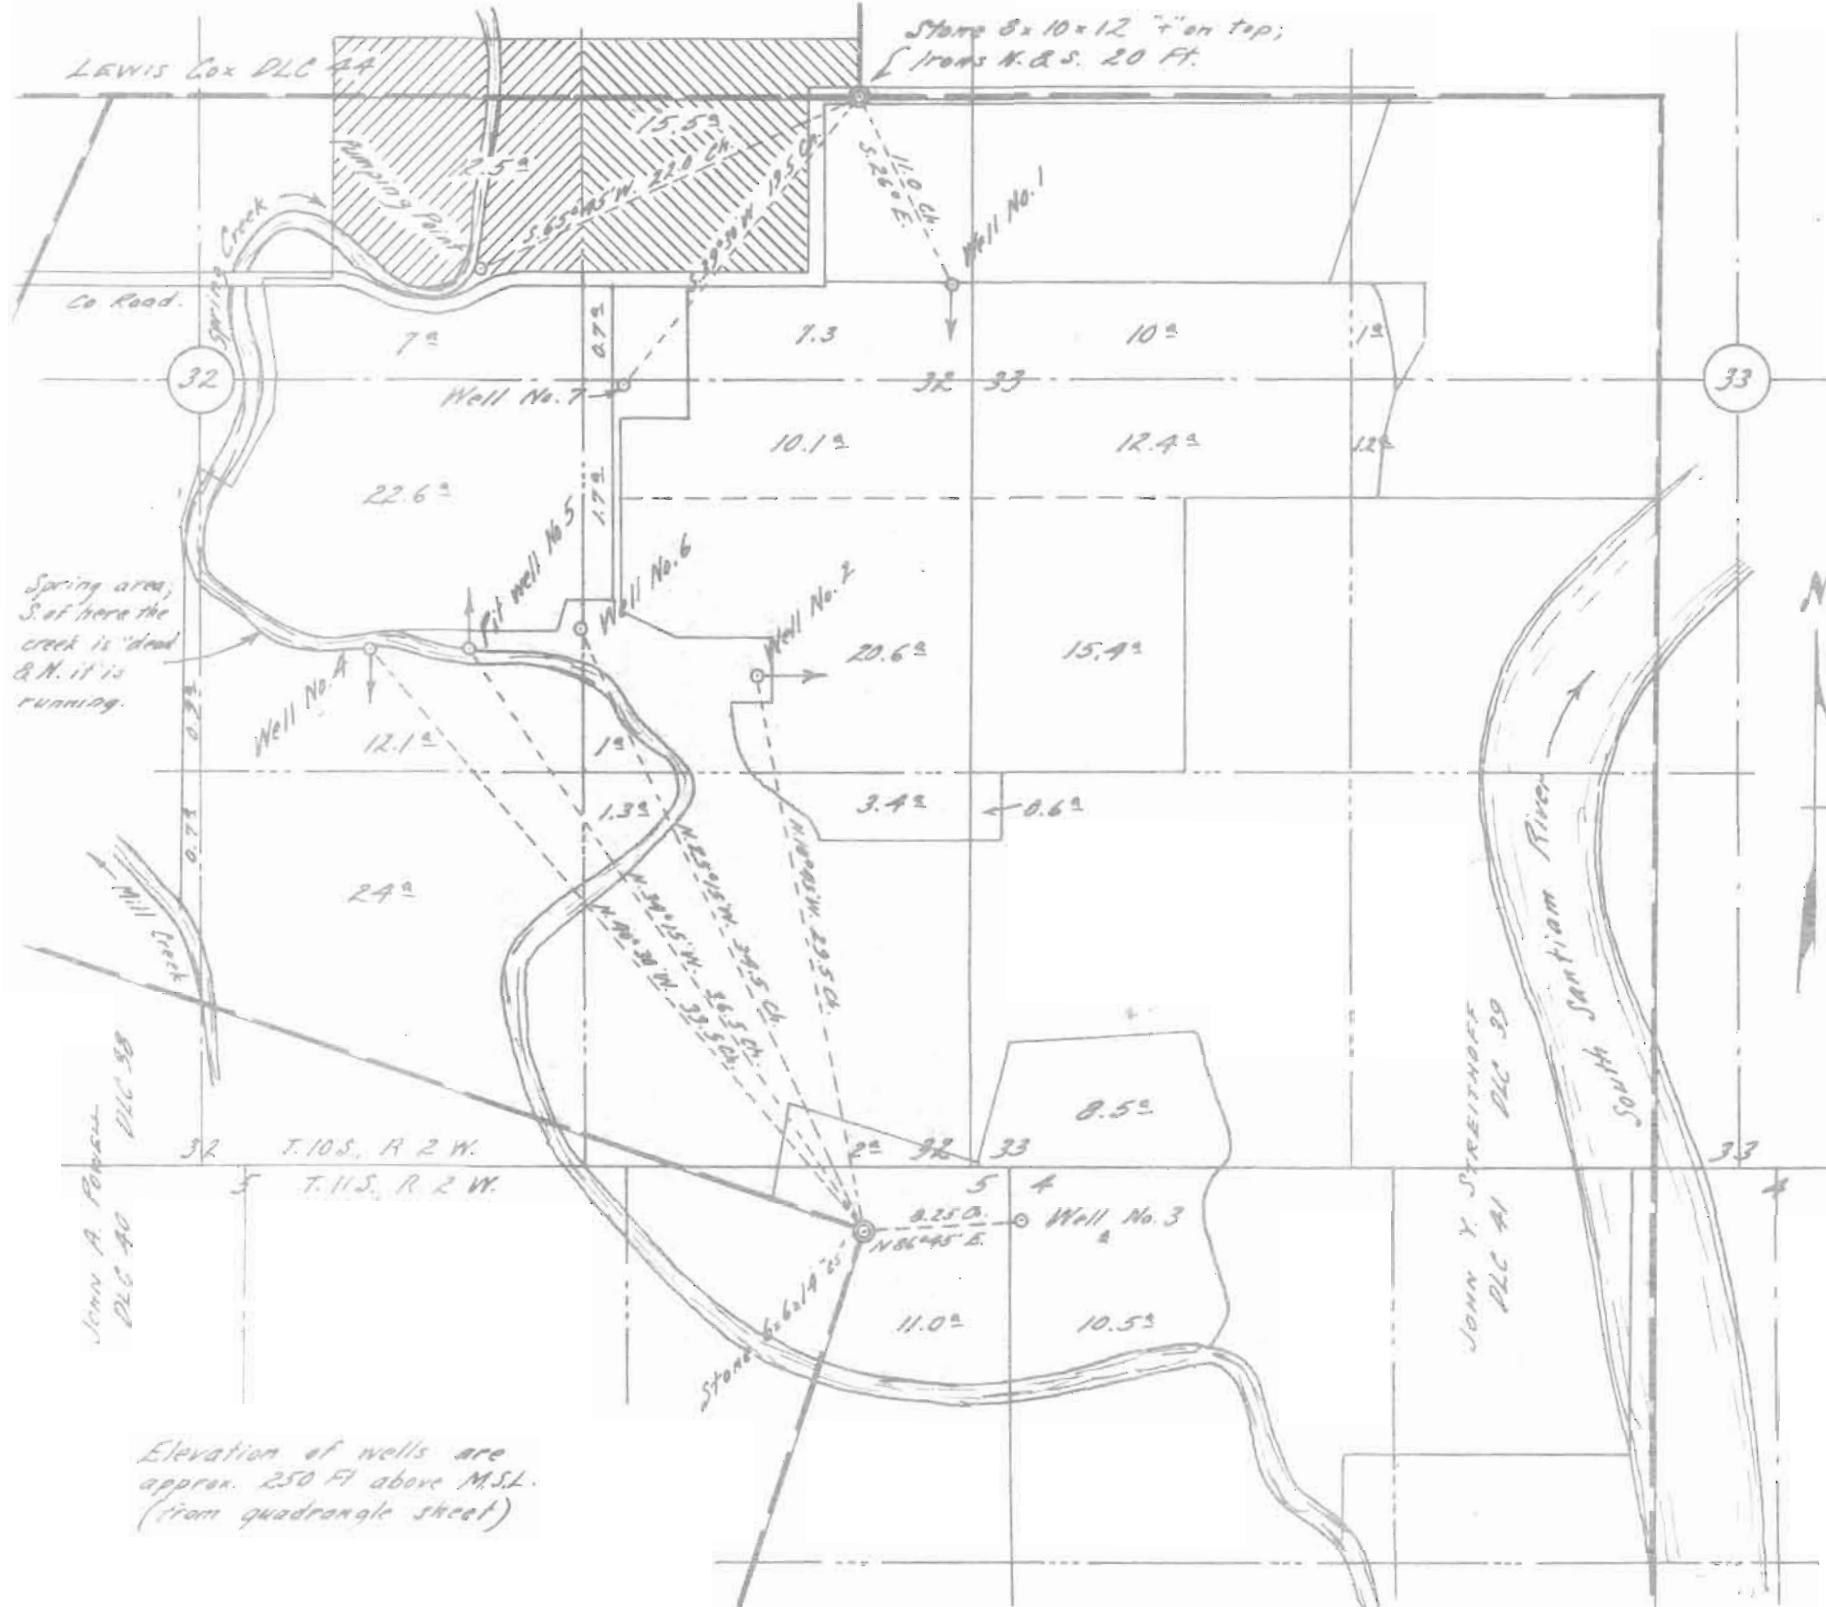

Elevation of wells are approx. 250 ft above M.S.L.
(from quadrangle sheet)

I, Orris A. Carnegie of Albany, Oregon do hereby certify that this map was made from notes on record in the office of the Linn County Surveyor and supplemented by information taken from the latest aerial photographs and from measurements furnished by Mr. Flagmann; that the monuments are as shown on this map.

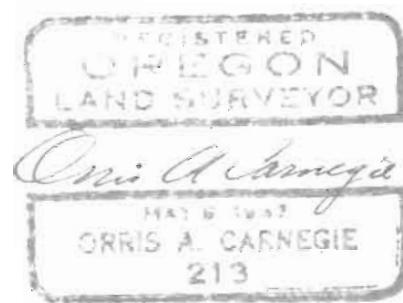

Mon No. 30685
Inv. No. 34180