


T.13S.R.31E.W.M.

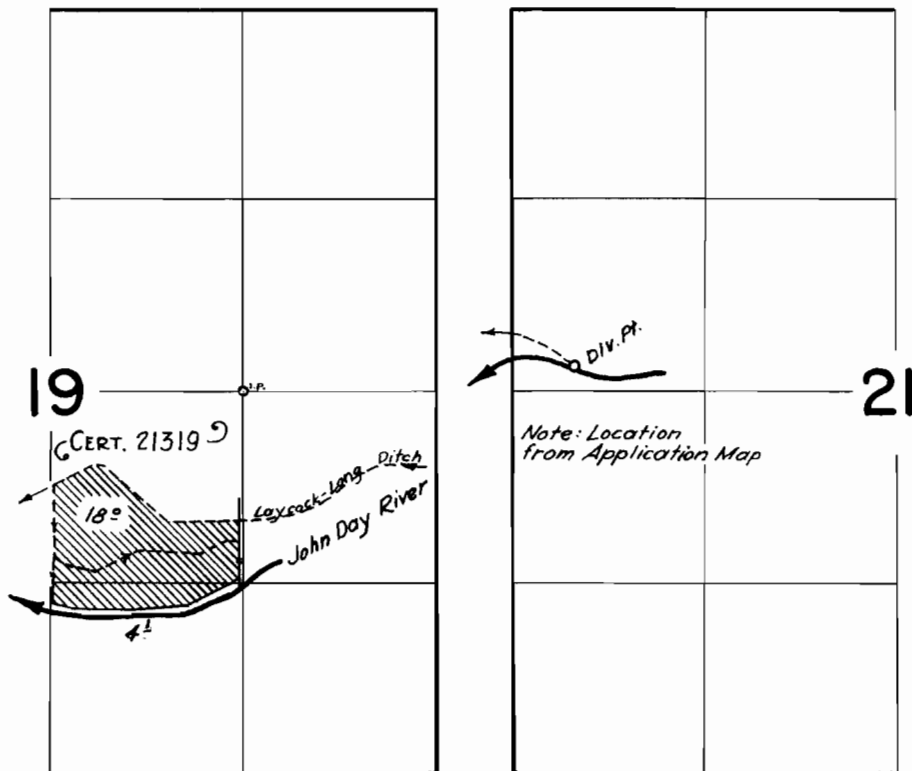

FINAL PROOF SURVEY UNDER

Application No. 30707 Permit No. 24189
IN NAME OF

CLARK MORRIS

Surveyed Sept. 21, 1961, by R. Jackson