


DEPARTMENT OF  
 LAND AND WATER RESOURCES  
 DIVISION OF SURVEYING  
 OREGON

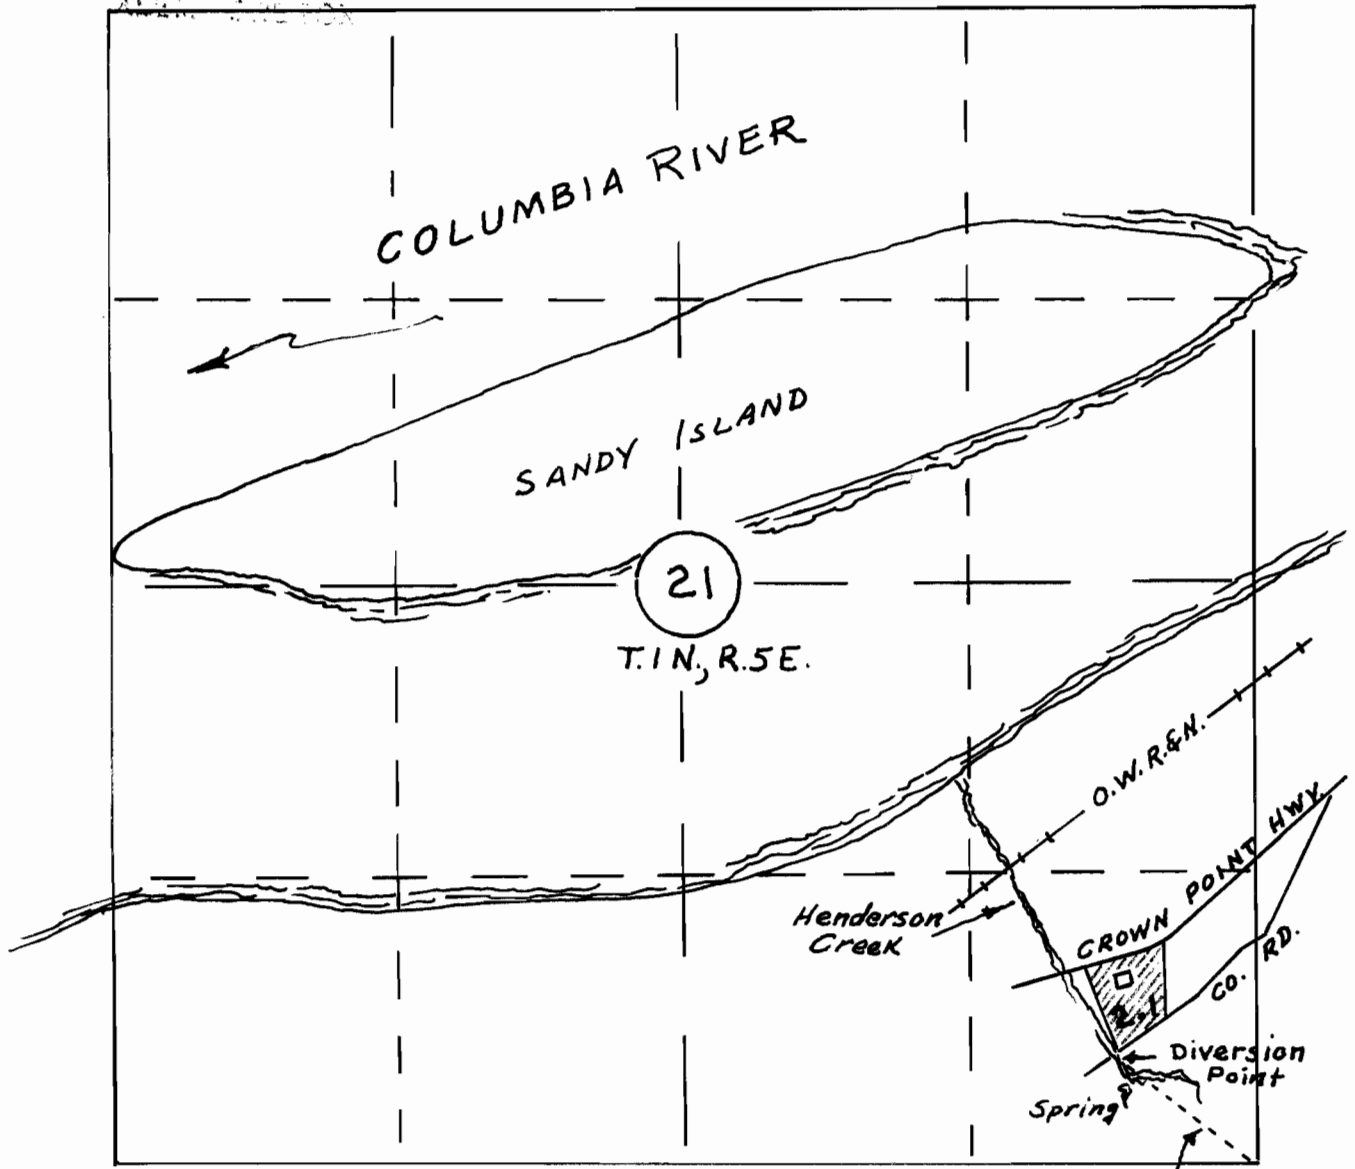

Approx. { N. 50° 30' W  
720'

About 555 feet of 1/2" pipe used from diversion point to house. Tank is 90' south of house. Water is taken for domestic use.

Application No. 24614  
 Permit No. 24299

Prepared by Dexter E. Milne, Surveyor, of Oregon City, Oregon, from information furnished by Queen Cheadle.

SCALE 1" = 880'  
 July, 1956