


RECEIVED
AUG 14 1956
STATE ENGINEER
SALEM, OREGON

T2S R9W WM

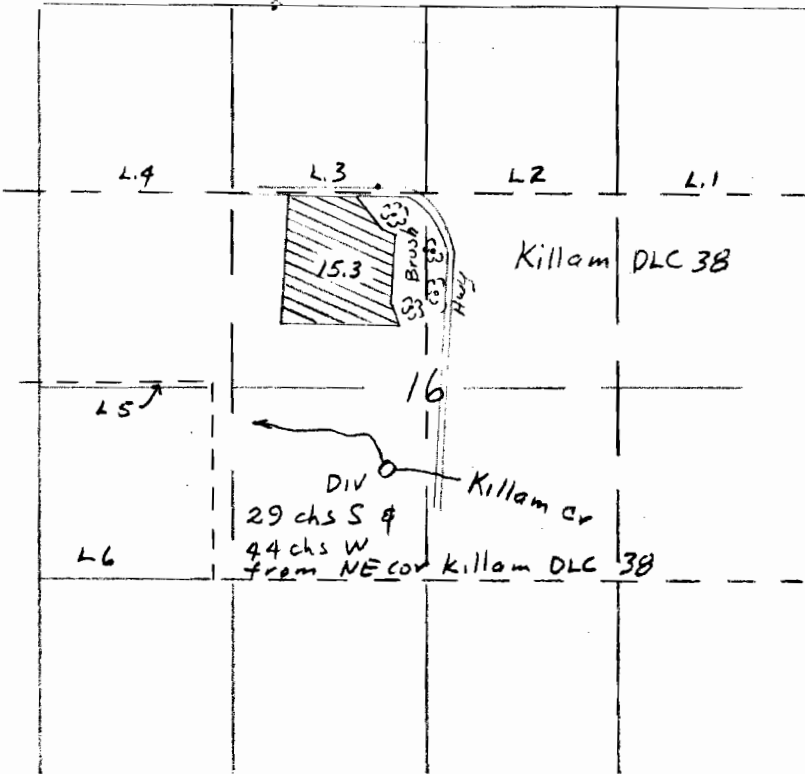

Appl 28274
Surveyed with Permit 22230 by RHW

Application No. 30860
Permit No. 24325