

9  
7  
12  
1  
0.00  
5.00  
W. 5.00

MHP


Accompanying application of Glen E. Duvall and E.G. Duvall to appropriate the public waters of the State of Oregon. Applicants land being located in the S.W. 1/4 of the N.E. 1/4 of Sec. 12, Twp. 4 South of Range 10, W.W.M. in Tillamook Co., State of Oregon.

5-1903.40  
W-1351.57  
Spring  
Pt. of Div.  
5-1898.27  
W-1366.07  
Res. Tile  
Conc. Tile  
Dia. 3/4"

Wallace Duvall to Lloyd Baylor  
1/2 in S.W. 1/4 of N.E. 1/4 of Sec. 12.


Scale: 1 inch = 50 feet

Location Sketch  
Not to Scale

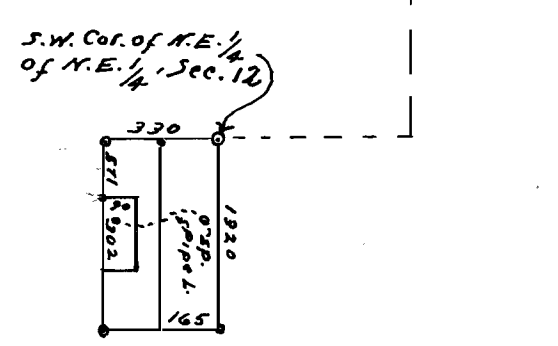


Frank E. Babcock  
Rep. Land Surveyor

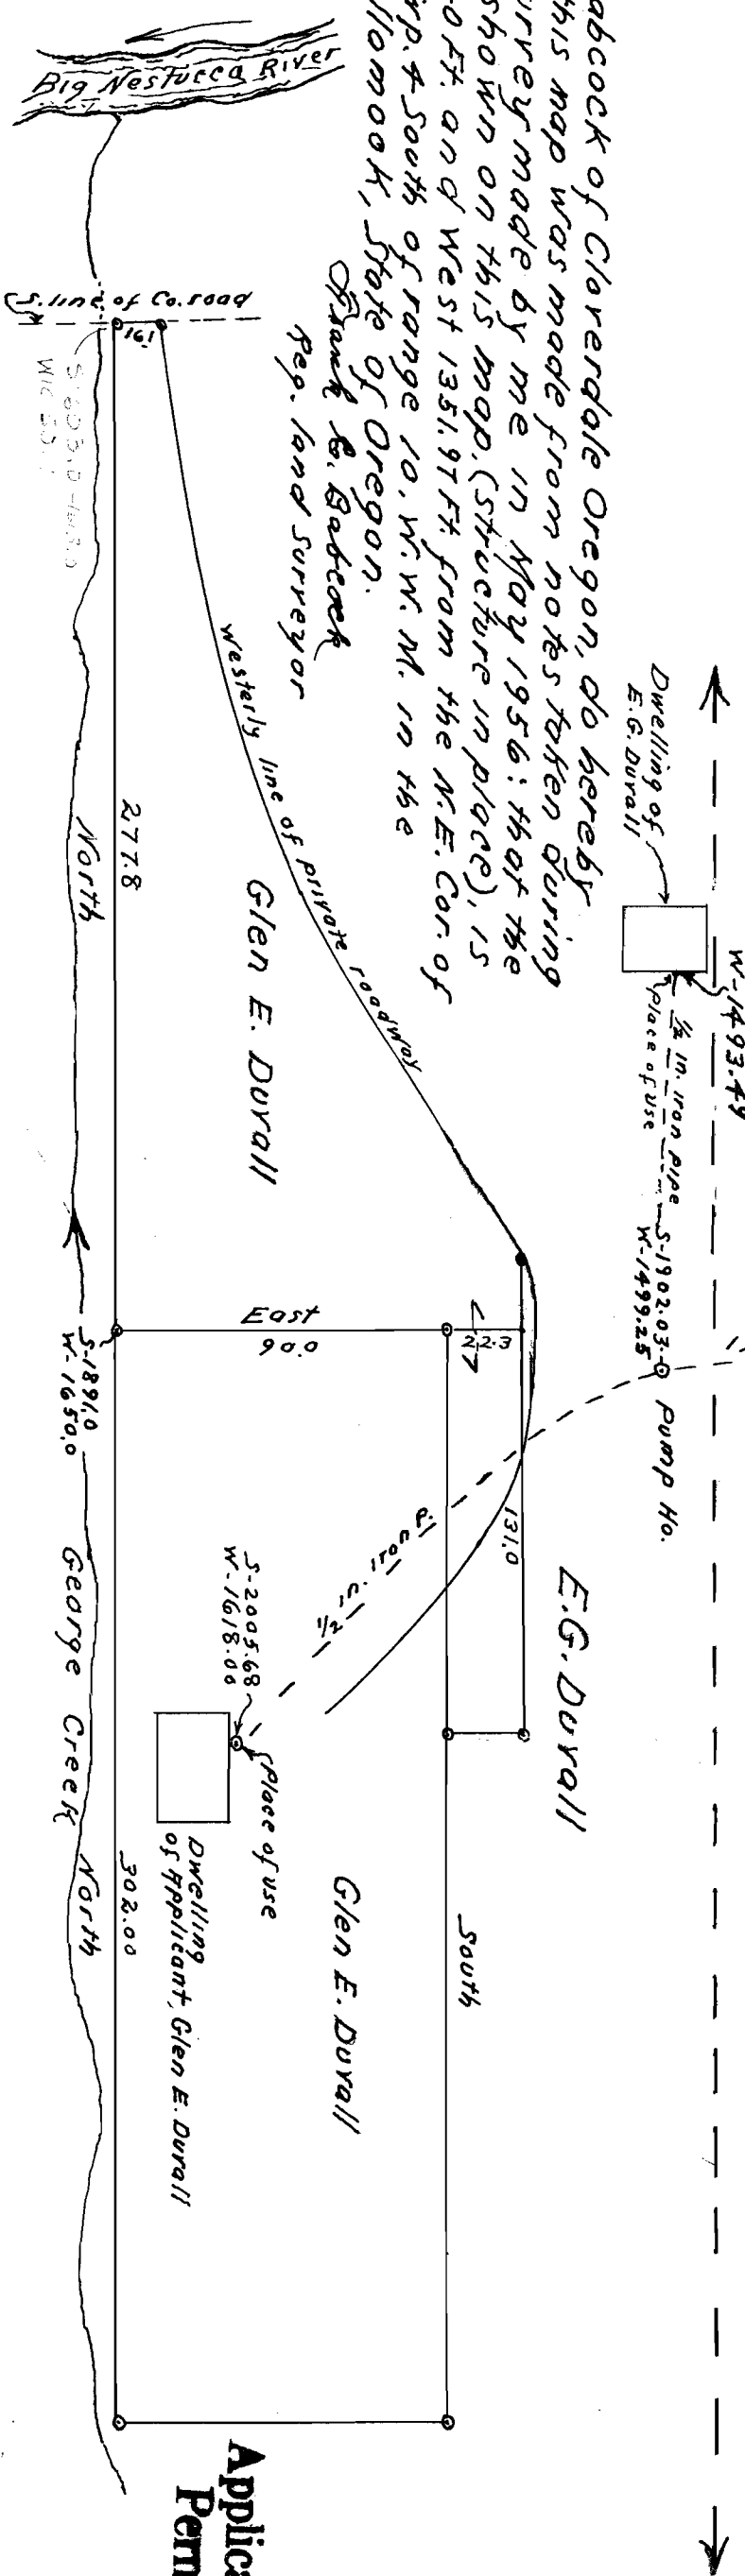

Application No. 30859  
Permit No. 24367