


T.40 S.R.8 W.W.M.

3

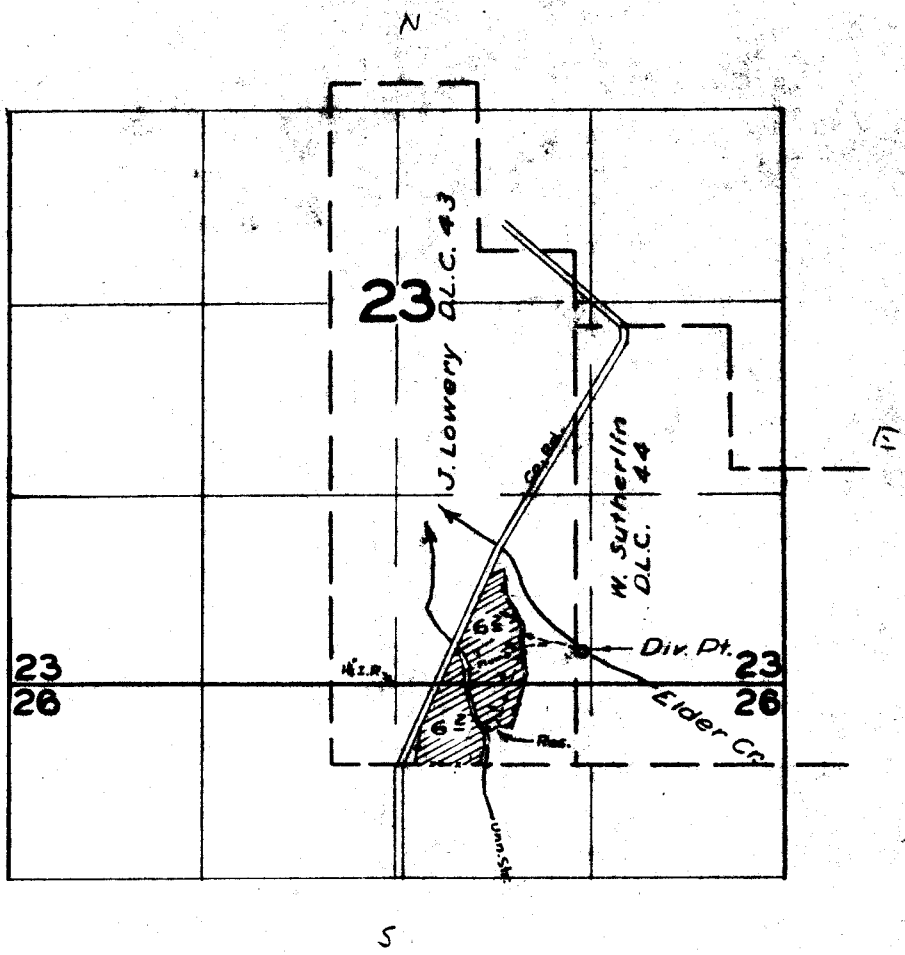

FINAL PROOF SURVEY UNDER

R 31066 R 1918113
 Application No. 31067 Permit No. 24424
 IN NAME OF

MARY WILSON

Surveyed 16 July 1959, by M. Rich