


# 24456

20  
-27  
RECEIVED

T. 37 S. R. 5 W. W. M.

SEP 18 1979

WM. DIST. 14  
GRANTS PASS, ORE.

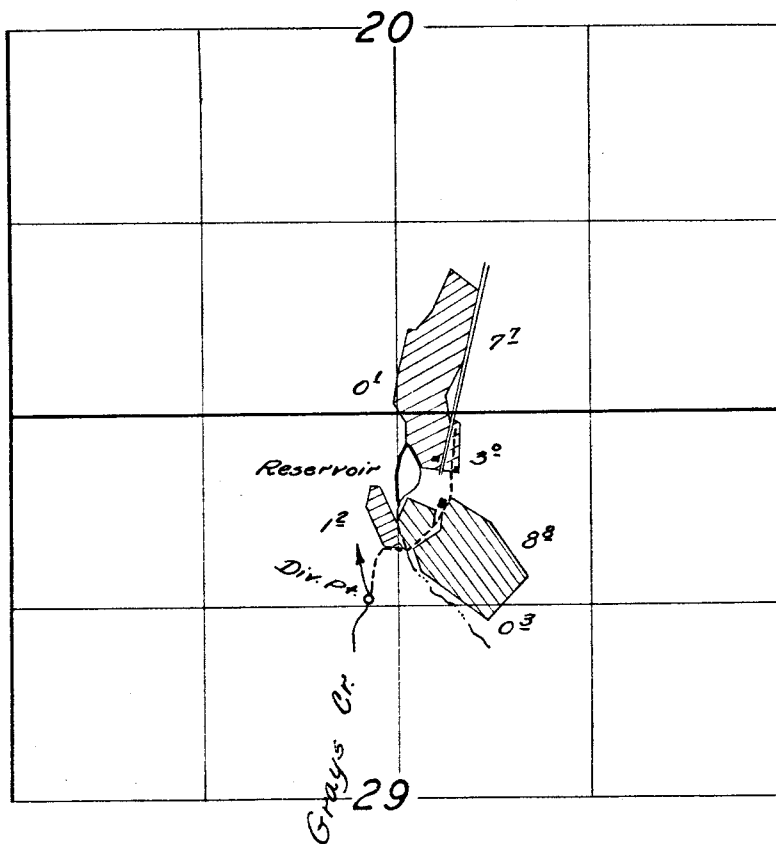

*[Faint handwritten notes and scribbles on the right side of the page]*

# FINAL PROOF SURVEY

UNDER

Application No. R-31038 / 31039 Permit No. R-1923 / 24456

IN NAME OF

Harold D. Fifer

Surveyed July 18 1959, by COBARTS