


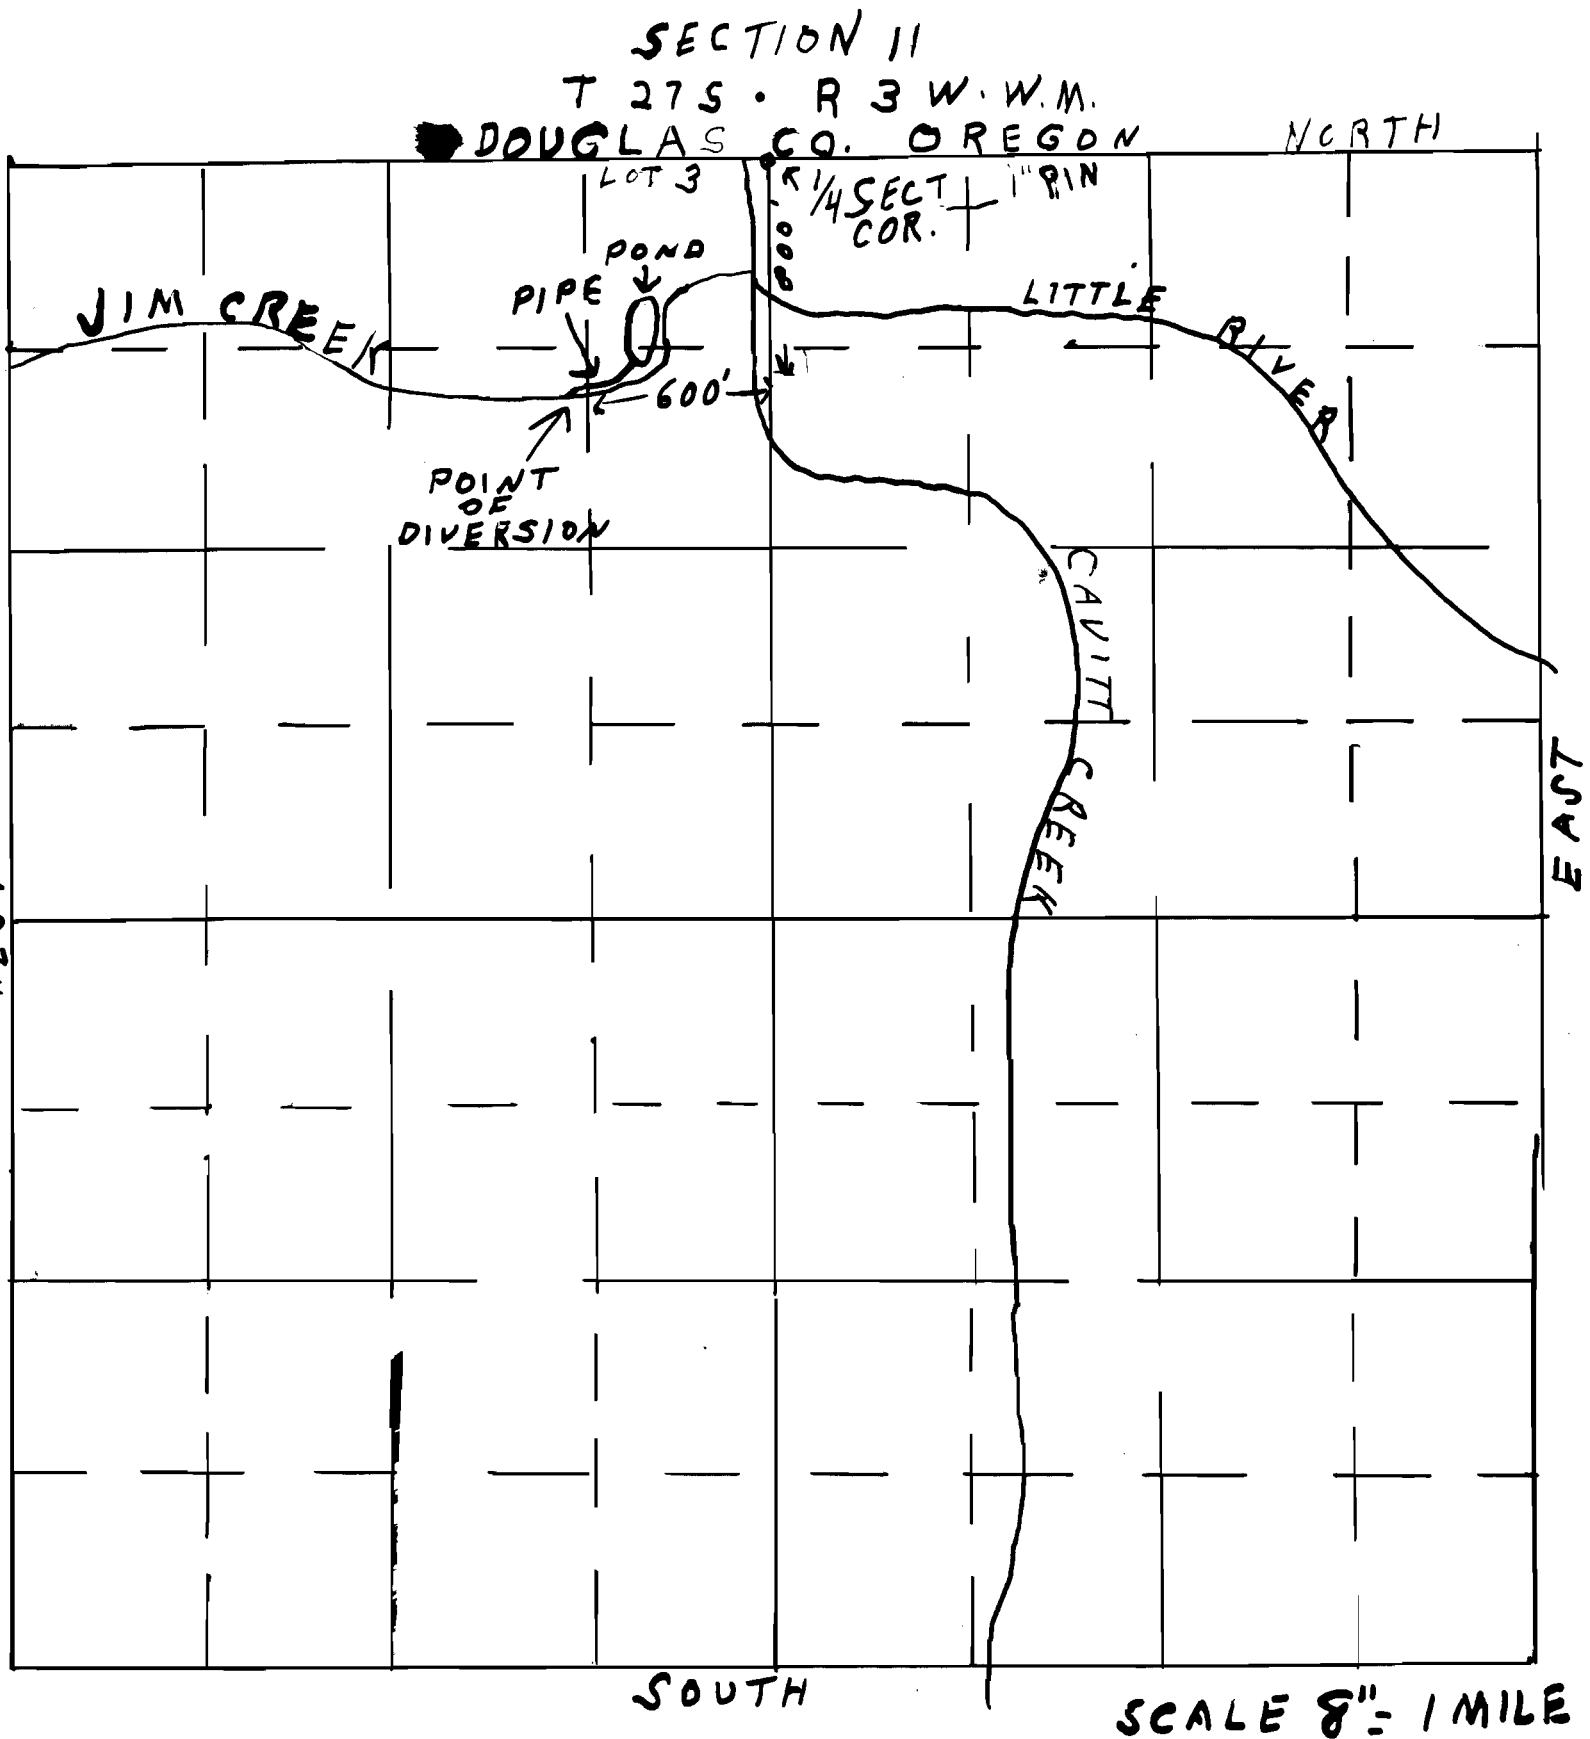

Application No. R-31138
31054
Permit No. R-1931
24458

DOUGLAS CO. OREGON
STATE ENGINEER
JAN 1 1931