


T.37 S.R.8W.W.M.

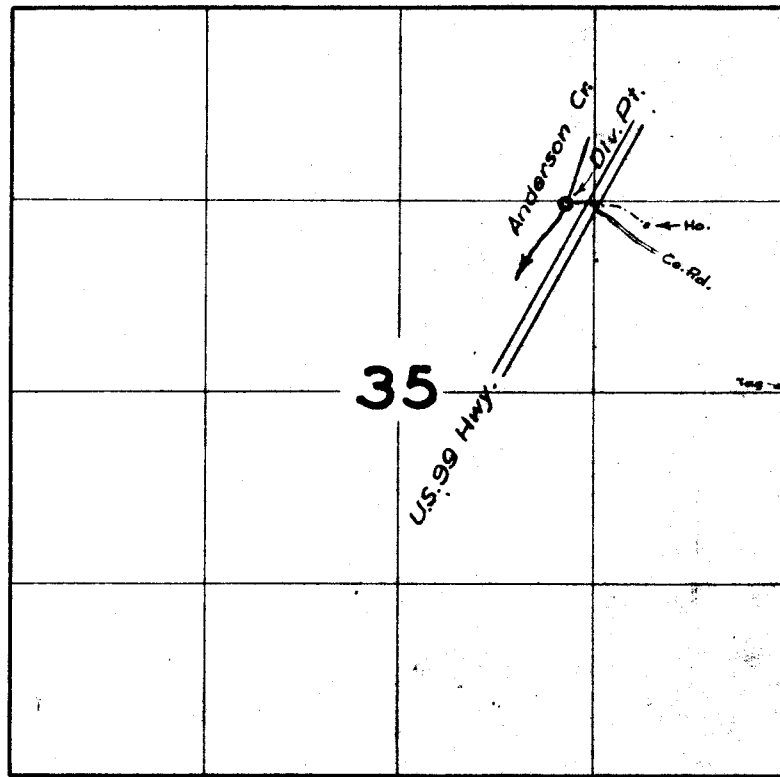

FINAL PROOF SURVEY
UNDER

Application No. 31148 Permit No. 24485
IN NAME OF

ADORE' BELDING HAMILTON

Surveyed 20 July 1959, by m. Bish