


T. 33 S., R. 1 E., W. M.

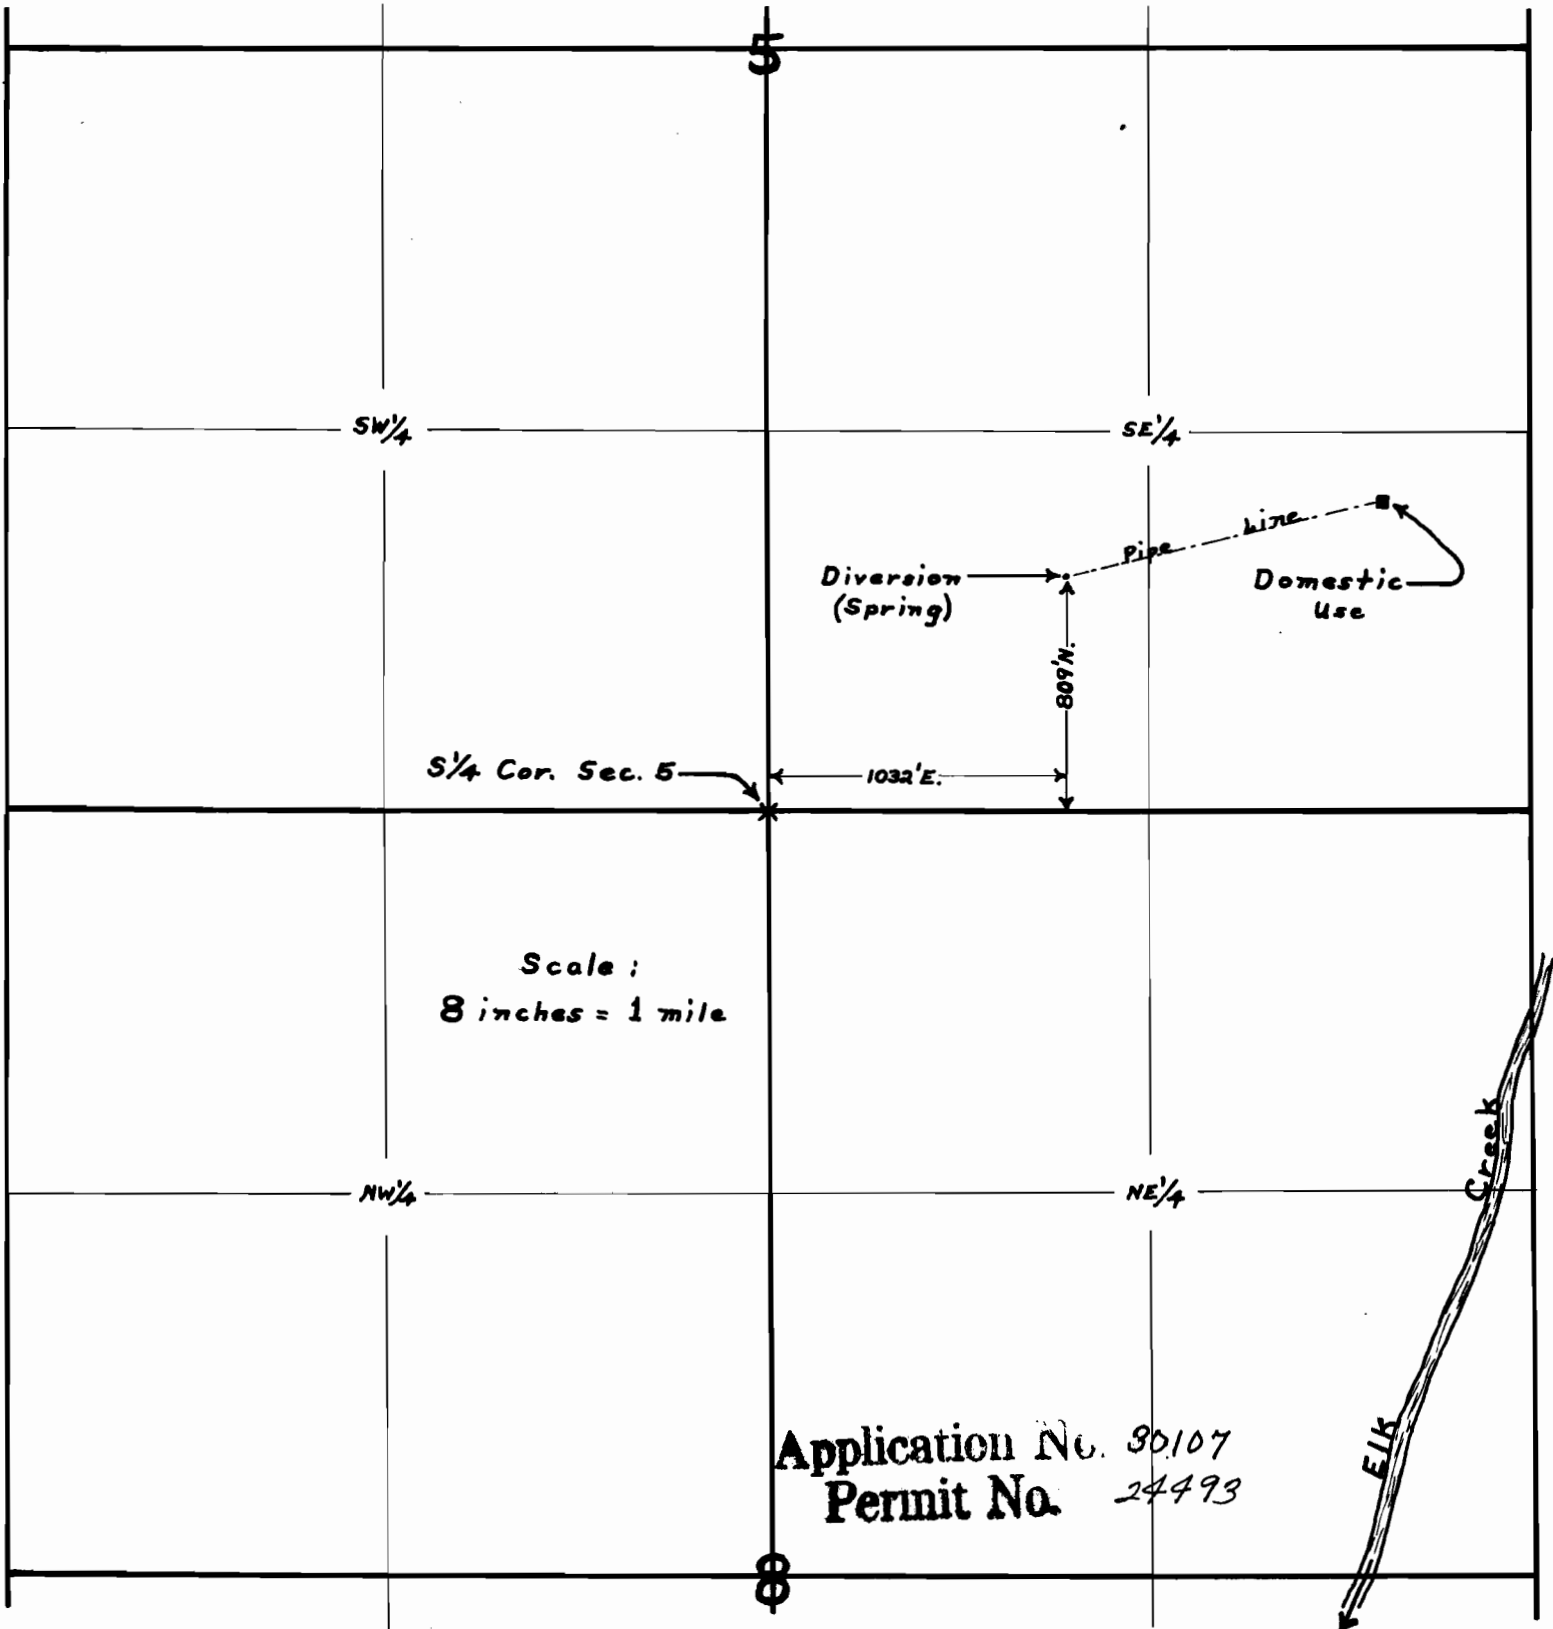

Map to accompany application of
Blanche Zimmerlee, for use of
water from a Spring for Domestic
purposes.

This Office - June 27, 1955

David C. Hendrix, Watermaster

30107