


T37S. R.5W. W.M.

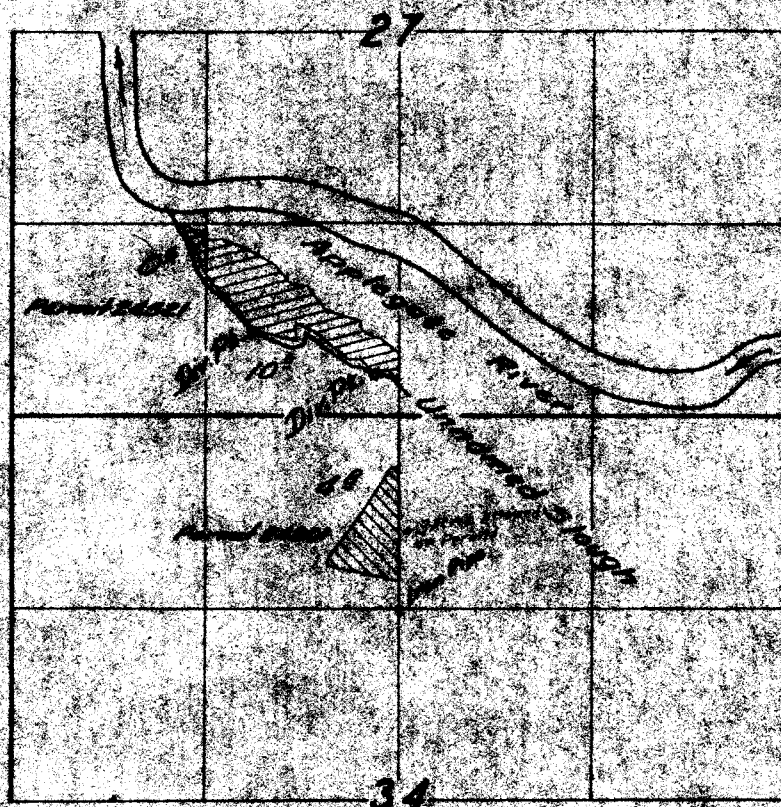

FINAL PLAN OF SURVEY

FOR


IN NAME OF

Don H. Jackson

Surveyed July 21, 1900, by Albion S. [unclear]