


*Lease in file*

T. 4 N. R. 24 & 25 E. W. M.

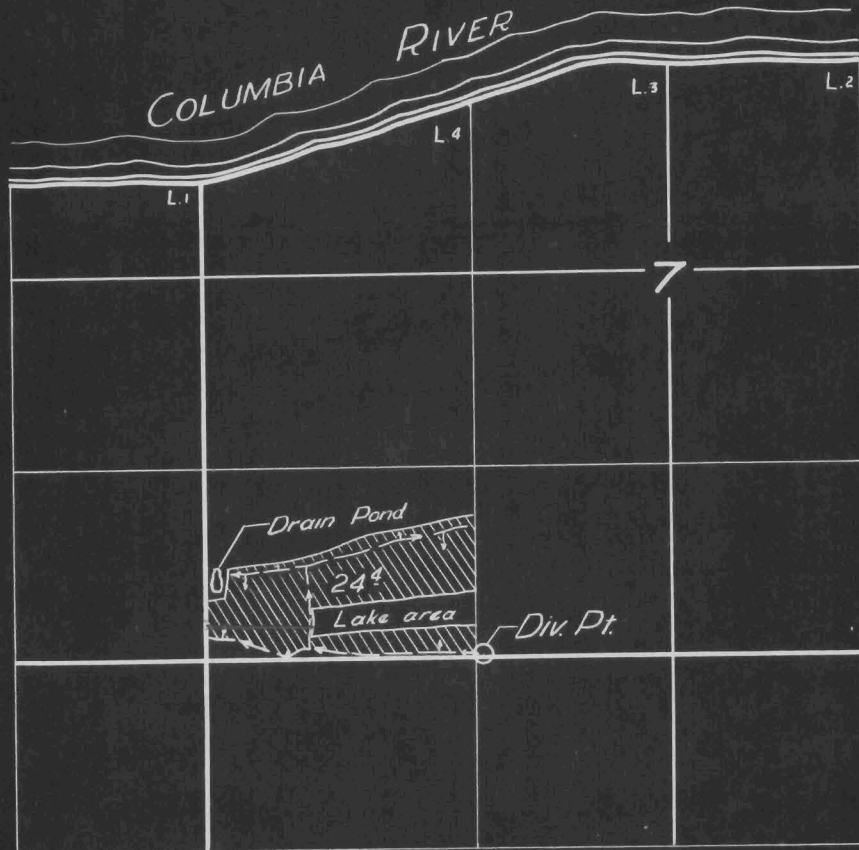

FINAL PROOF SURVEY  
UNDER

Application No. 24688 Permit No. 19487  
IN NAME OF

**CHARLES A. ANDEREGG**

Surveyed 12 Apr. 1955, by T. JONES

Application No. 31158  
Permit No. 27523

1955-Z

*Lease in file*