


TWP 39 S R 5 W W M

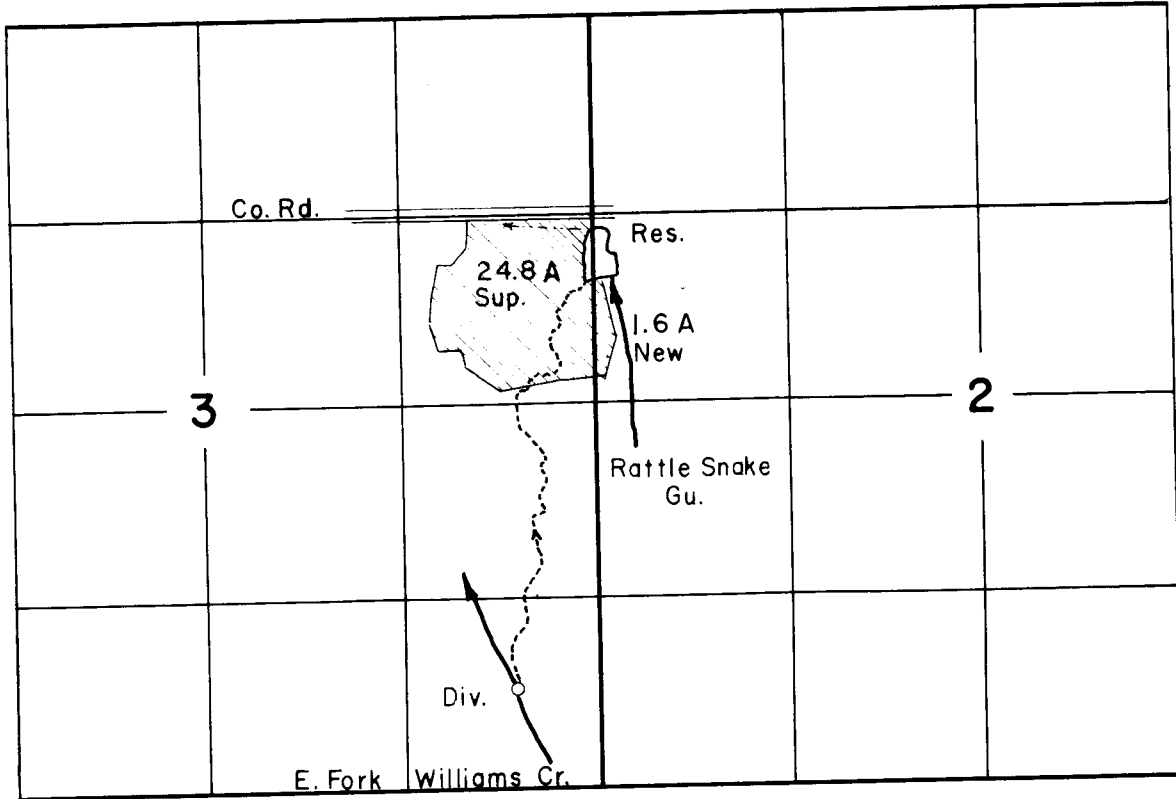


FINAL PROOF SURVEY UNDER

Application No. **R-31168** **R-1954**
31169 Permit No. **24564**
 IN NAME OF

Loy & Lena Yokum

Surveyed 11-8 1961, by Steimer

T.39S., R.5W., W.M.

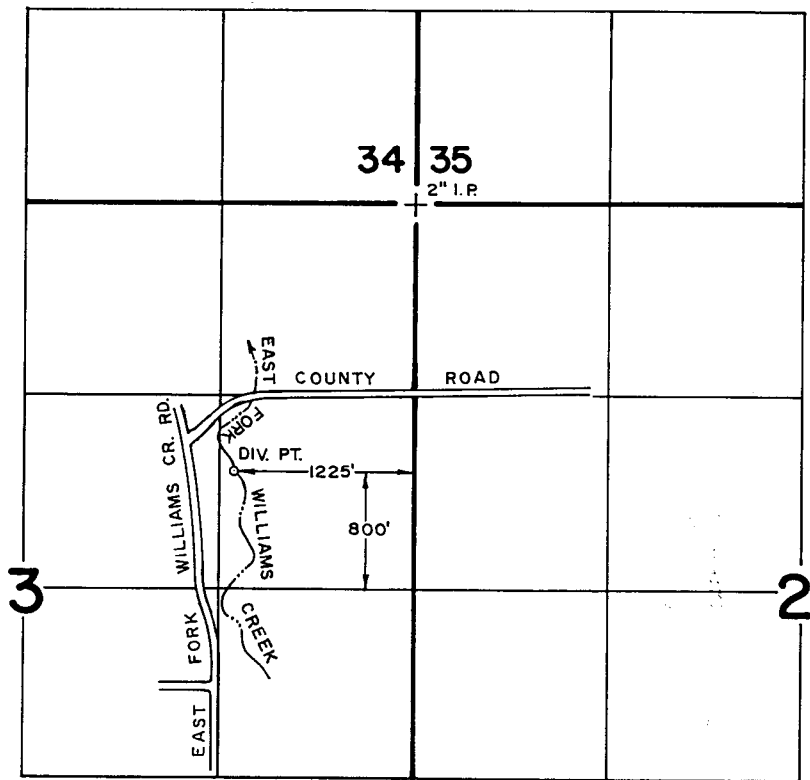

RECEIVED

SEP 10 1987

WM DIST. 14
GRANT PASS, ORE.

FINAL PROOF SURVEY

UNDER

TRANSFER NO. 4418

Application No. Permit No.
IN NAME OF

DEAN M. & REBECCA K. GARDINER

Surveyed AUG. 11, 1983, by B. SUZIE JAMES

SCALE: 4" = 1 MILE