


Permit: S 24568
 Volume: 6B
 RES Strm: UNN STR/F-S RES 1
 Trib: THOMPSON CR
 Priority: 10/23/56

T.39S.R.5W.W.M.

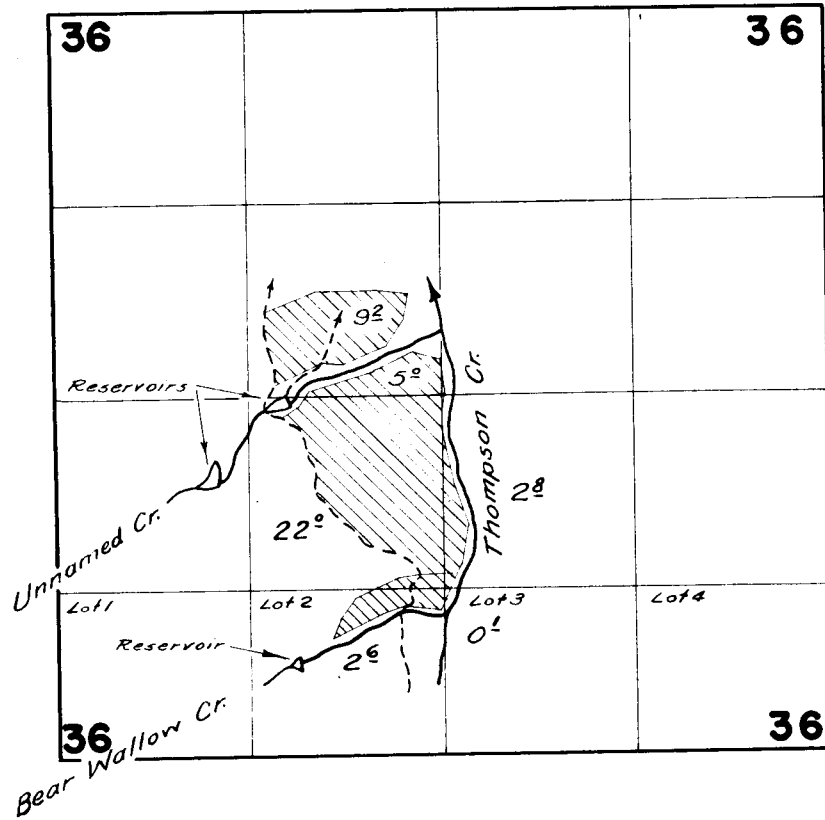

FINAL PROOF SURVEY UNDER

Application No. 31180 Permit No. 24569
 R-31179 R-1957
 31178 24568
 R-31177 R-1956

IN NAME OF
FIELDS-STONE

Surveyed July 23 1959 by *C.O. Bartels*