


Permit: S 24569
 Volume: 6B
 Strm: BEAR WALLOW/FS RSC
 Trib: THOMPSON CR
 Priority: 10/23/56

T.39S.R.5W.W.M.

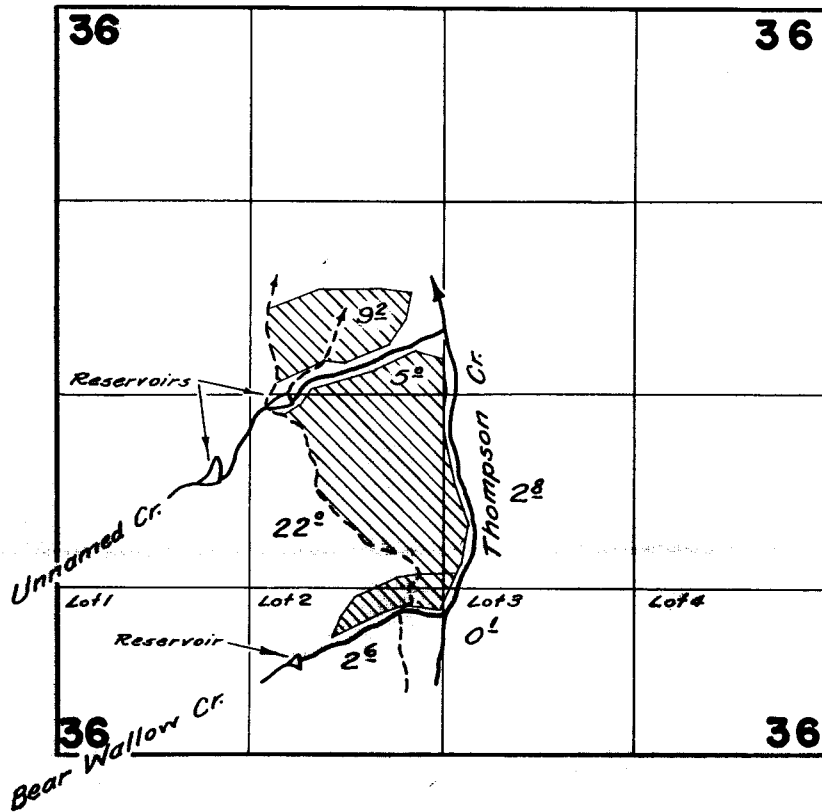

FINAL PROOF SURVEY UNDER

Application No. 31180 Permit No. 24569
R-31179 R-1957
31178 24568
R-31177 R-1956
 IN NAME OF

FIELDS-STONE

Surveyed July 23, 1959, by C.D. Baile

RECEIVED

MAR 14 1991

WM. DIST. 14
 GRANTS PASS, ORE.

1859-V