


This spring is located at a point 9.75 chains West and 75 links South of the center of section 4 in T₂₂ S. R. 5 W. Will. Met. in county road and is to be conveyed to house a distance of 90 ft.

The house bears N 75° E from spring.

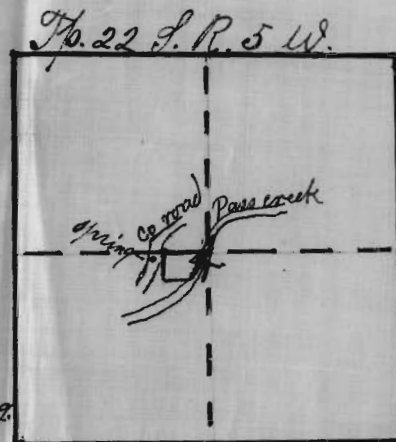

I O. F. Thiel of Monroe, Douglas County Oregon, do hereby certify that this map was made from notes taken during an actual survey made by me on February 5th 1910. and that it correctly represents the works described in the accompanying application together with the location of stream.

O. F. Thiel
Surveyor

Application # 508

Permit # 246