


# T. 37 S. R. 7 W. W.M.

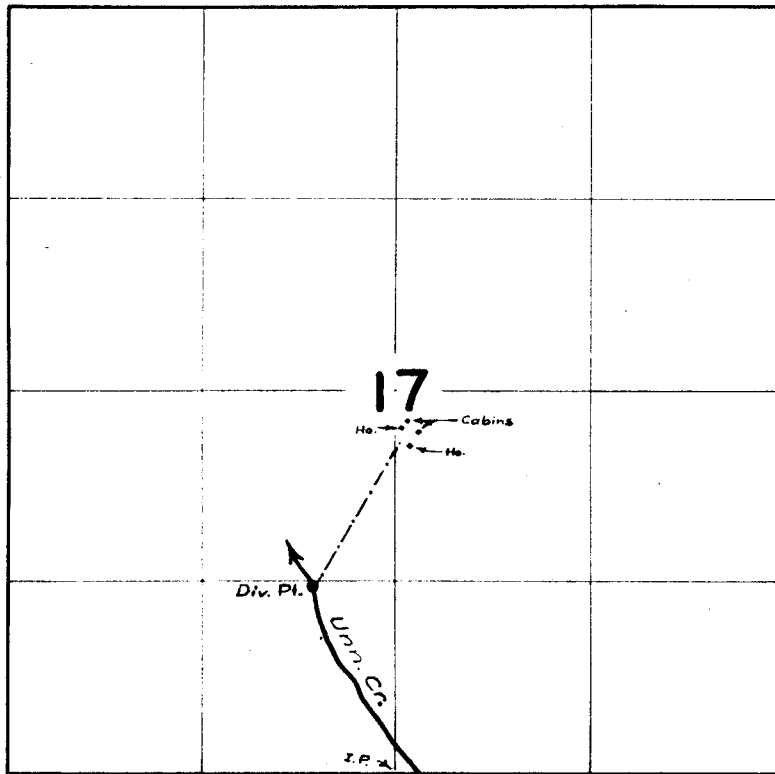

## FINAL PROOF SURVEY UNDER

Application No. 31263 Permit No. 24631  
IN NAME OF

GLEN L. CHAPMAN

Surveyed 23 July 1959, by *m. Beck*