


T.38S. R.5W.W.M.

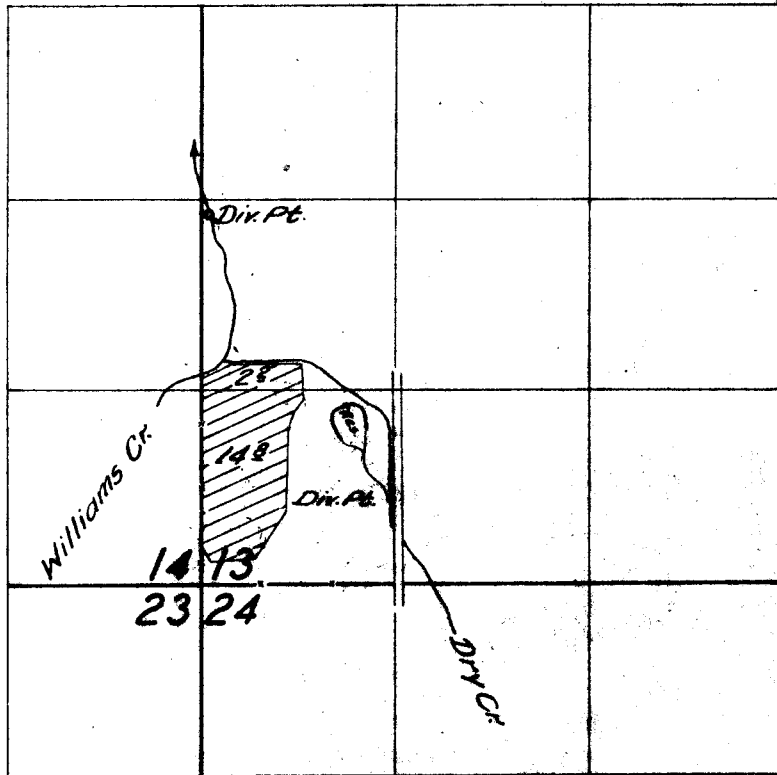

FINAL PROOF SURVEY

UNDER

Application No. R-31295 Permit No. R-1974  
31296 24647

IN NAME OF

ROBERT E. THOMAS

Surveyed July 22, 1959, by C.O. Bartlett