


T.36S. R.5W.W.M.

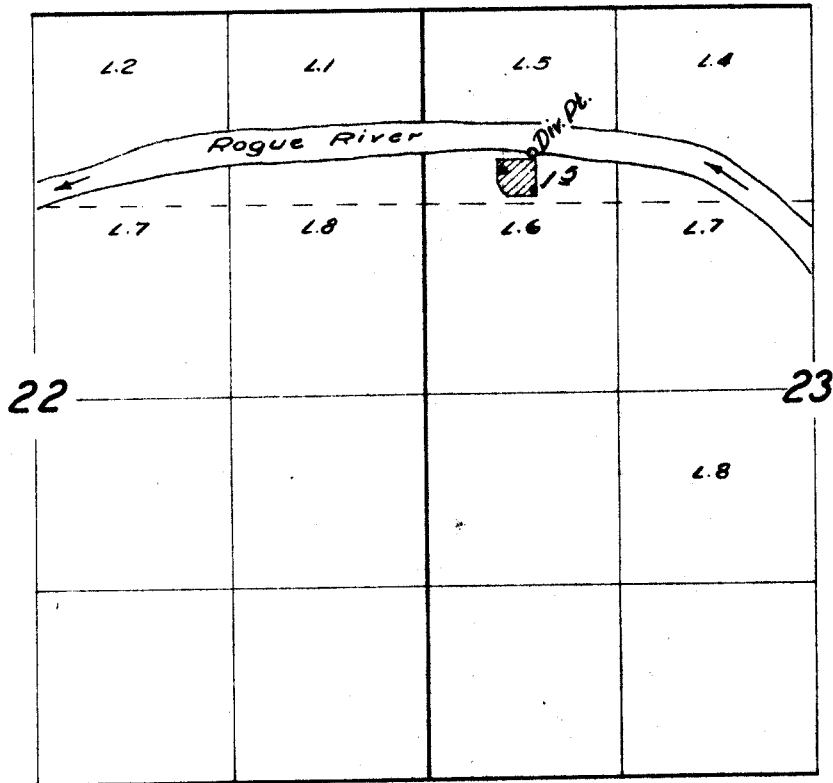

FINAL PROOF SURVEY

UNDER

Application No. 31378 Permit No. 24740

IN NAME OF

*Dietz Newland*

Survey July 14, 1959, by *C.O. Bartsch*