


TOWNSHIP 14 SOUTH, RANGE 21 EAST, W.M.

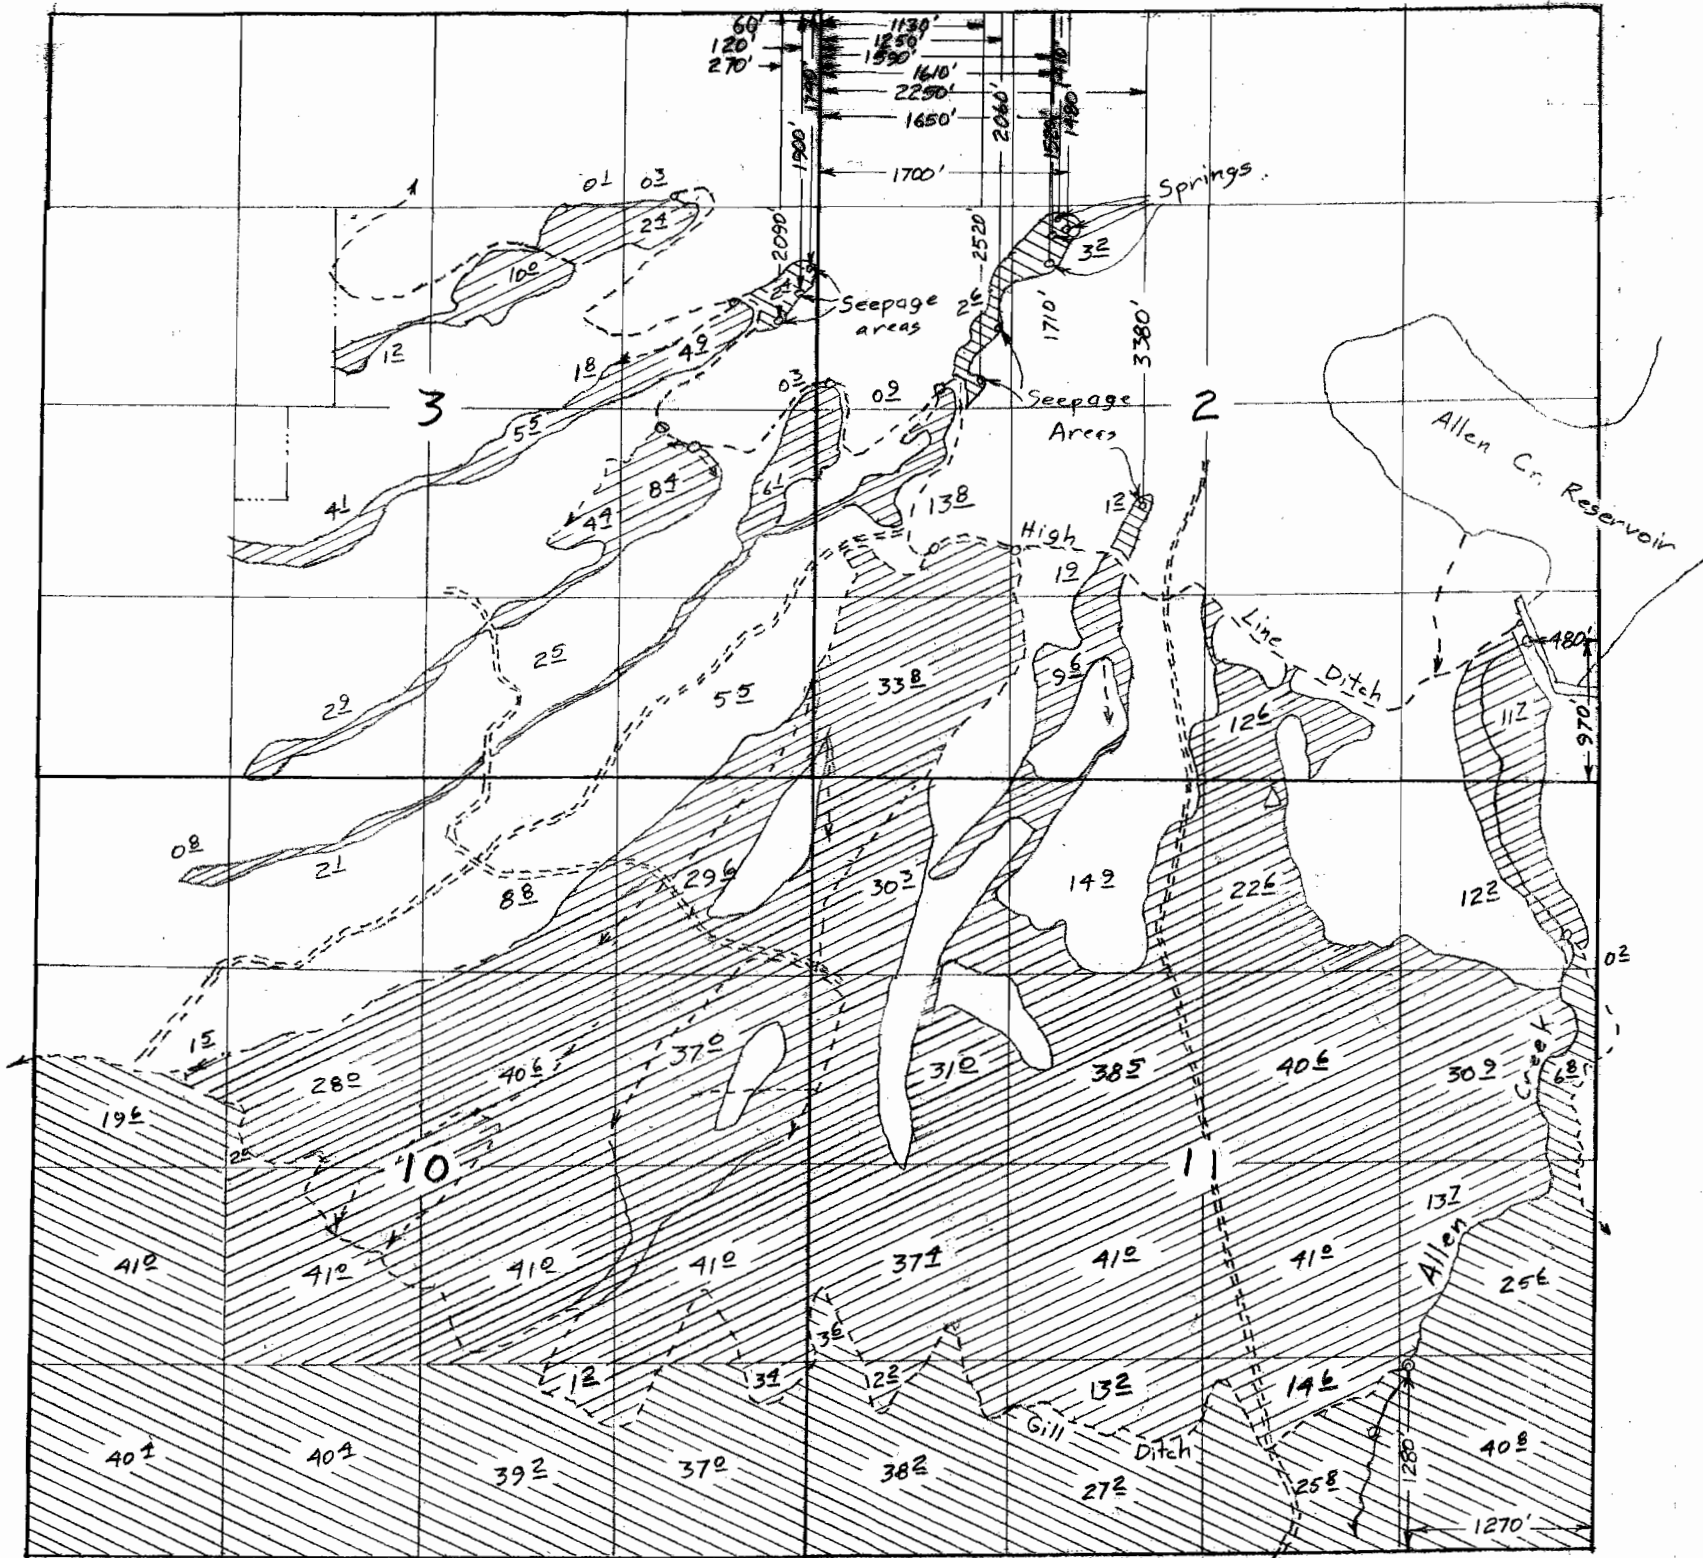

Claim of Beneficial Use Map  
for  
Les Schwab Tire Centers of Oregon  
(LS Ranch portion of Allen Creek  
and Springs/Seepage Areas under  
application 30100, permit 24774)


- ⊗ Allen Creek (1193 $\frac{1}{2}$  acres)
- ⊗ Springs/Seepage Areas (9 $\frac{1}{2}$  acres)

Scale 1"=1320'

RECEIVED

JUN 01 2005

WATER RESOURCES DEPT  
SALEM, OREGON

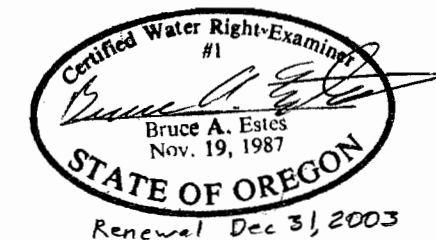

Surveyed August 14 & September 9 & 10, 2003

This map is for the purpose of  
locating a water right only  
and has no intent to provide  
legal dimensions or the location  
of property lines.

**ESTES SURVEYS, LLC**

PO Box 17519 60382 Arnold Rd  
Salem, OR 97305-7519 Bend, OR 97702  
(503) 585-7593 (541) 382-7391

Amended 28 May 05