

Vol. 4
APP'GATE R
M180


Permit: S 24801
Volume: 6A
Strm: DALES BLUFF CR
Trib: APPLEGATE R
Priority: 3/29/57

27

T. 37 S., R. 5 W., N. M.

Scale 4" = 1 mile March 1957

Don H. Jackson

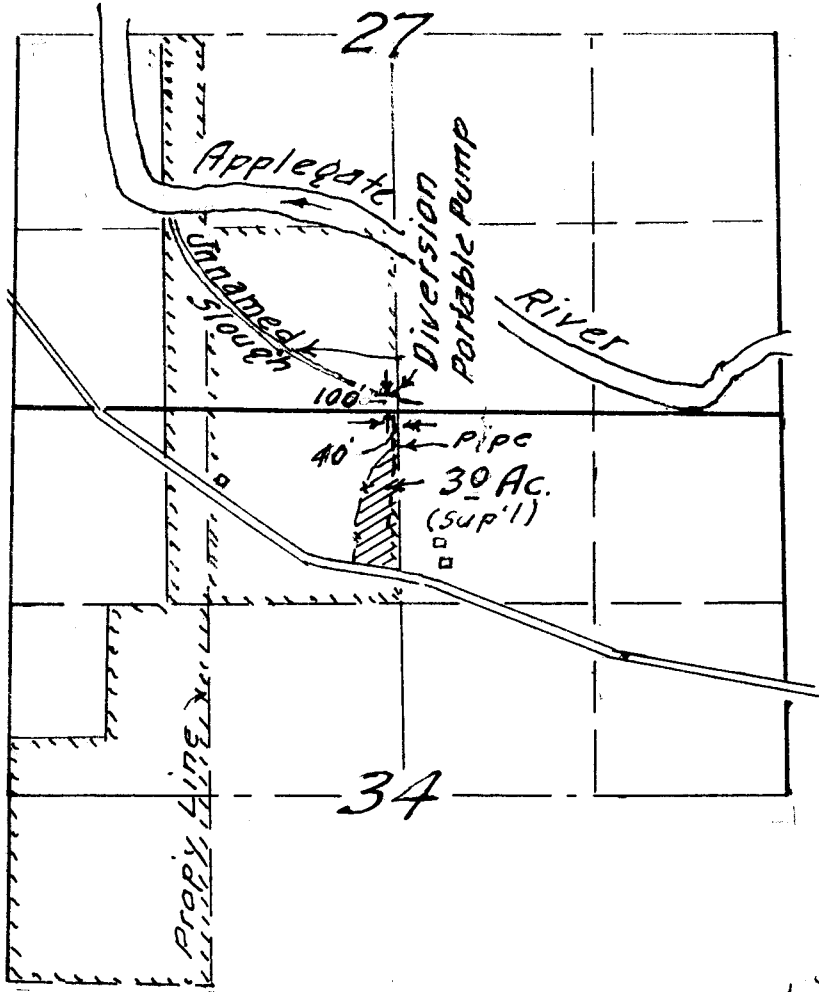

See Final Proof

Application No. 31451
Permit No. 24801