


DELBERT AND AGNES SANDNER

Township 9 S., Range 1 W.W.M.

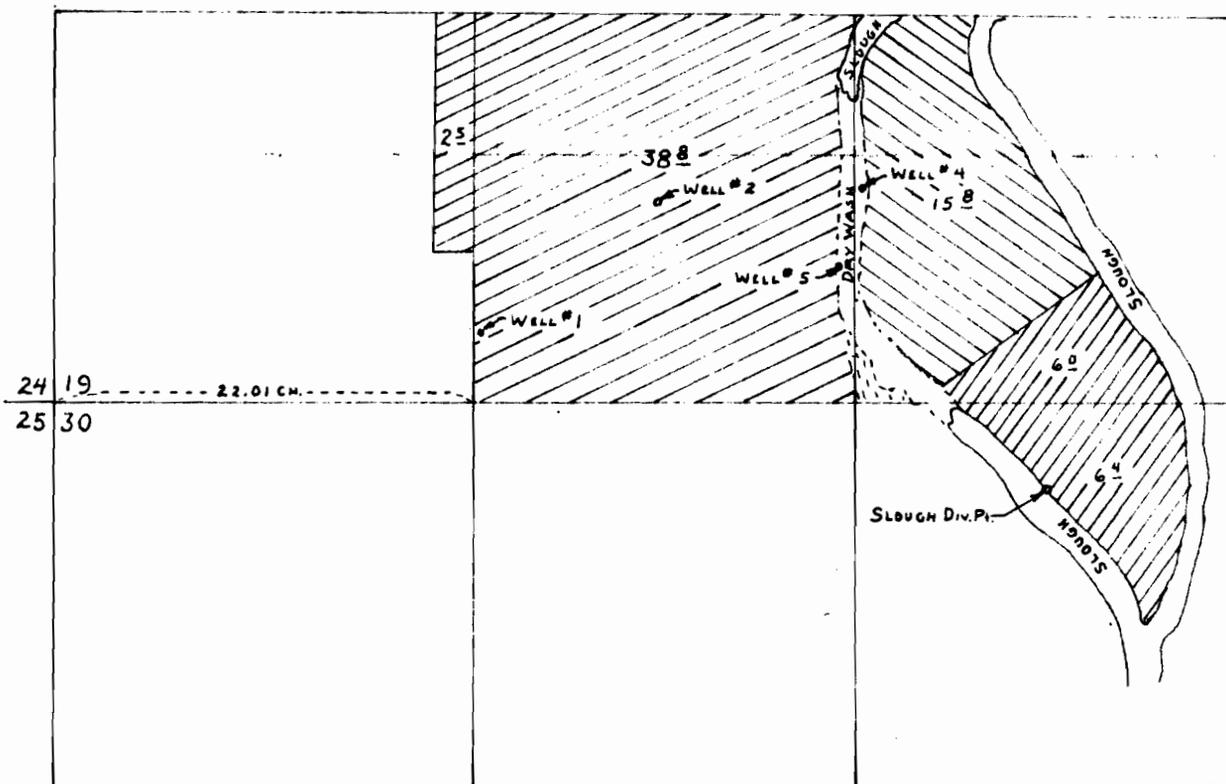

The Following listed Wells and Diversion Point are located in reference to the S.W. Corner of Section 19.

Well #1 - Registration - N 79°48'E, 22.2 Ch.

Well #2 - Registration - N 71°30'E, 33.29 Ch.

Well #4 - New Well - N 75°28'E, 45.11 Ch.

Well #5 - Camp Ground Domestic - N 80°04'E, 41.56 Ch.

Slough of North Santiam River - S 85°14'E, 32.2 Ch.

Application No. G-666 § 31590
Permit No. G-609 § 24967