


T. 22 S. R. 5 W. WM.

Scale 1 inch = 400 ft.

July 1957

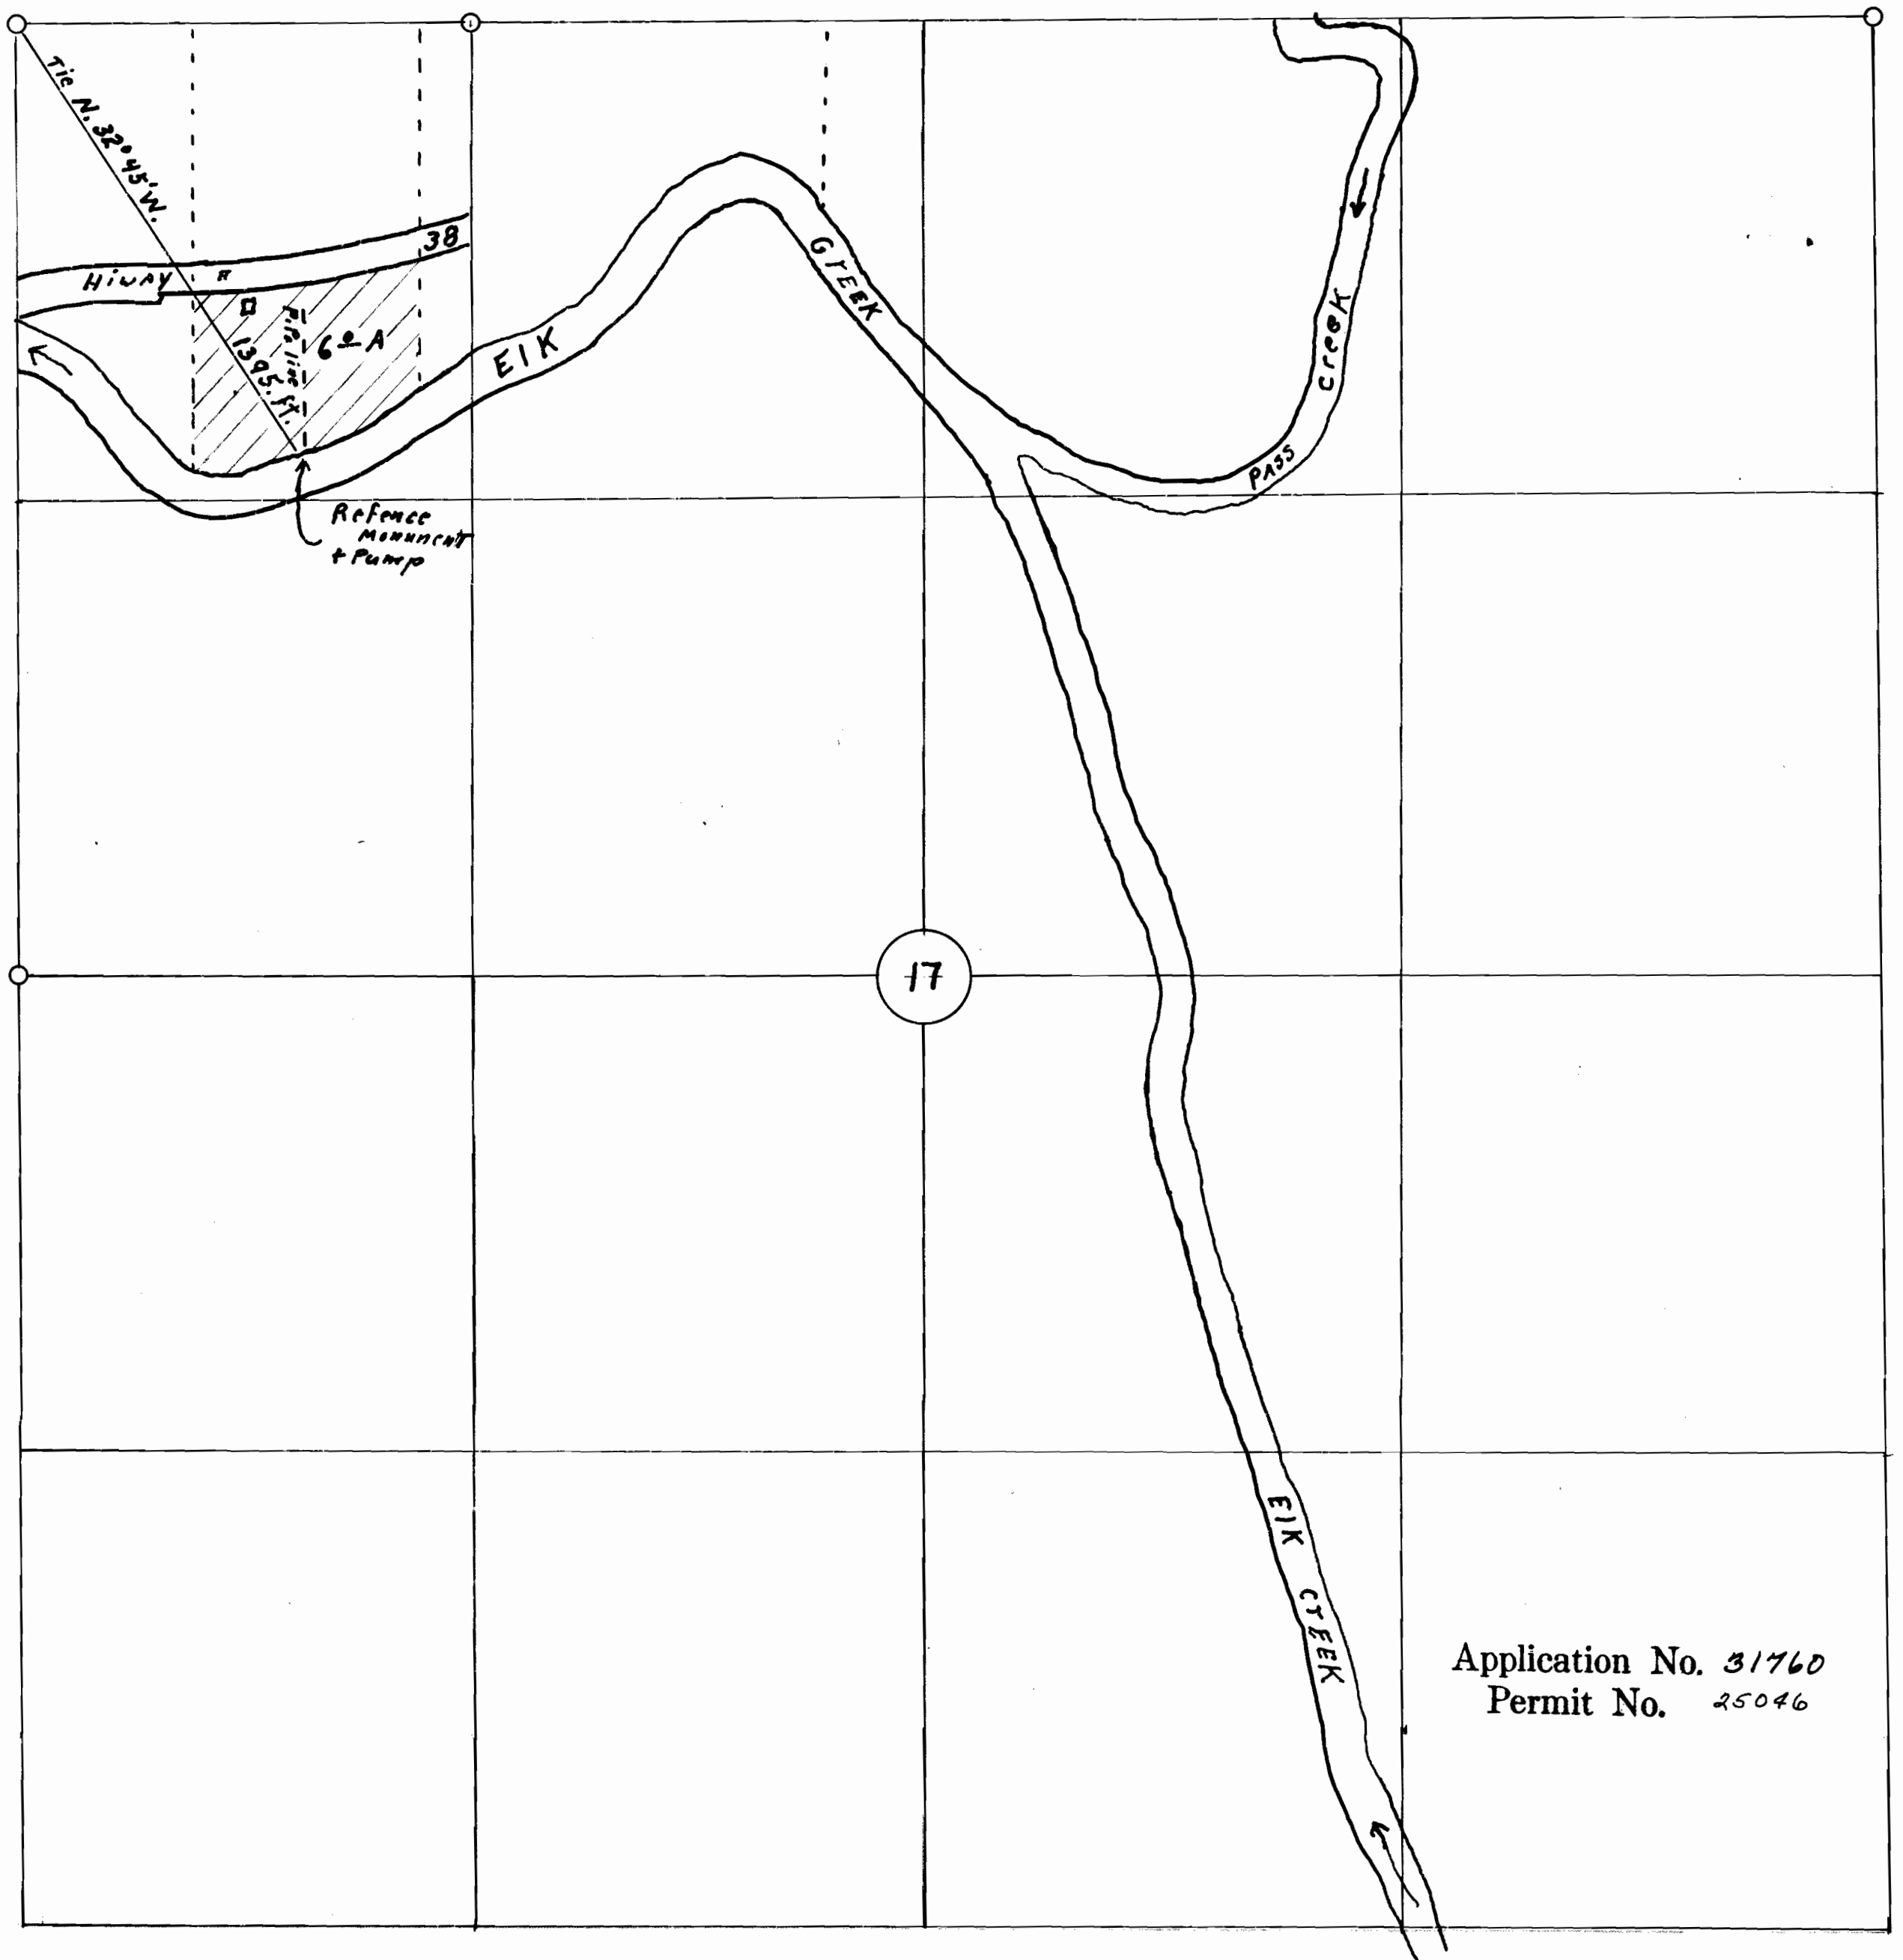

Application No. 31760
Permit No. 25046