



Map of  
**SCHOUTEN DITCH**

John Schouten  
 Appropriator

Scale 4" = 1 Mile,

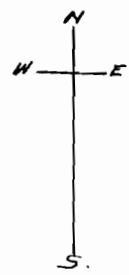

T175

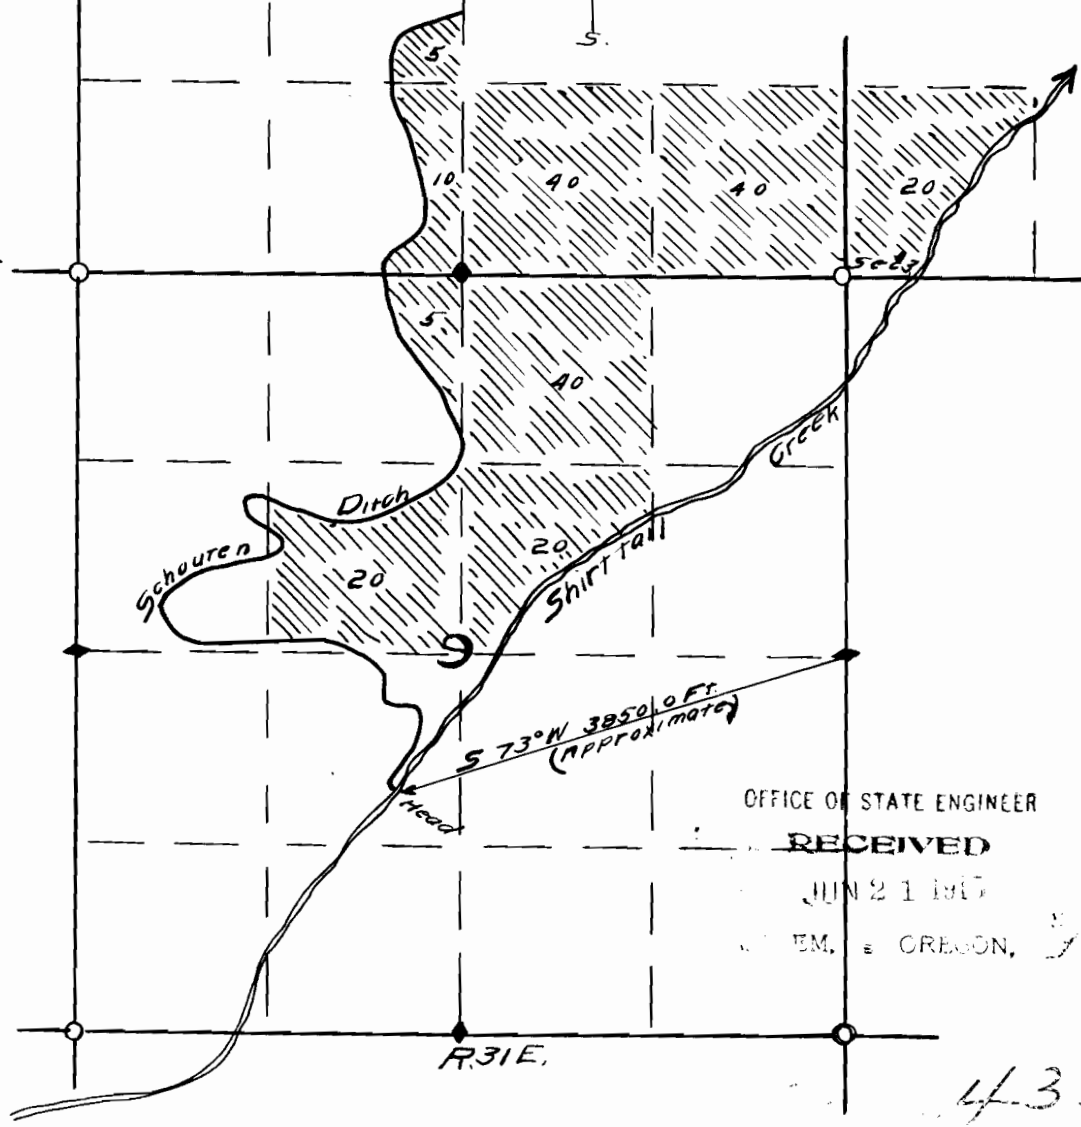

R.31E.

OFFICE OF STATE ENGINEER

RECEIVED

JUN 21 1907

EM. OREGON.

433  
 2505