


25072
39-5-2

T.39S.R.5W.W.M.

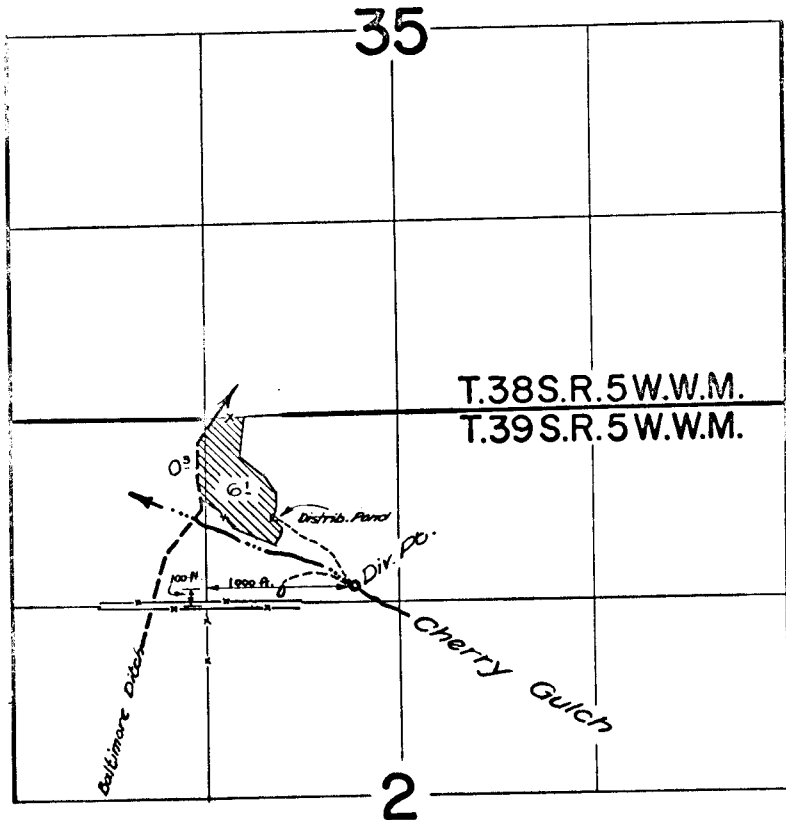

FINAL PROOF SURVEY UNDER

Application No. 31554 Permit No. 25072
IN NAME OF

..... DWAYNE D. PROSE

Surveyed July 17 1965, by *R.H. Jackson*