


Permit: S 25075  
Volume: 6B  
Strm: UNN STR  
Trib: BANNING CR  
Priority: 5/22/57

# T.38S.R.5W.W.M.

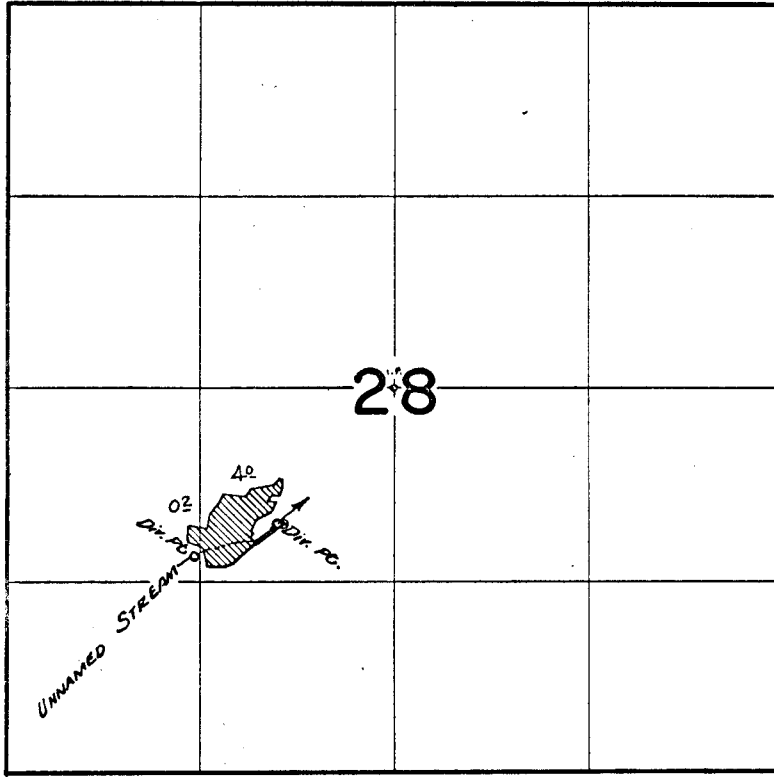

*Upstream div. pt. is located 1150 ft. South & 1340 ft. West from center Sec. 28  
Downstream div. pt. is located 920 ft. South & 790 ft. West from center Sec. 28*

## FINAL PROOF SURVEY UNDER

Application No. 31577... Permit No. 25075...  
IN NAME OF

CHARLES E. & BLANCHE HOWE

Surveyed July 17, 1965, by *R. Jackson*