


DATE: NOVEMBER 14, 1957.

DESCRIPTION OF THE TRACT OF LAND AS GIVEN IN TITLE INSURANCE POLICY NO. M-9303 ISSUED BY TITLE & TRUST CO., DATED NOVEMBER 3, 1943, TO JUNIOR F. ECKLEY AND MILDRED E. ECKLEY, HUSBAND AND WIFE. (JUNIOR F. ECKLEY BEING ONE AND THE SAME PERSON AS FRANK JUNIOR ECKLEY OF THE PRESENT APPLICATION). APPLICATION #31842, PENDING.

Sec 25, and  
Sec. 36, T.7.S. R. 6 W. W. M.

BEGINNING AT THE NORTHEAST CORNER OF LOT 22 OF LAUTERMAN'S LACREOLE SUMMER HOME TRACTS, SAID CORNER BEING 1811.0 FEET SOUTH 89 DEGREES 54 1/2 WEST AND 3.1 FEET NORTH OF THE CORNER TO SECTIONS 25 AND 36 IN TOWNSHIP 7 SOUTH, RANGE 6 WEST AND SECTIONS 30 AND 31 IN TOWNSHIP 7 SOUTH, RANGE 5 WEST OF THE WILLAMETTE MERIDIAN IN POLK COUNTY, OREGON; THENCE SOUTH 75 DEGREES 20 WEST ALONG A LINE NEAR THE CENTER OF LACREOLE CREEK 247.85 FEET TO AN ANGLE CORNER IN THE DEED TO EMILY A BOISE RECORDED NOVEMBER 13, 1913, VOL. 59, PAGE 133, POLK COUNTY DEED RECORDS; THENCE NORTH 16 DEGREES WEST ALONG THE WESTERLY LINE OF SAID EMILY A BOISE'S TRACT 2.37 CHAINS TO AN IRON PIPE AT THE NORTHWEST CORNER OF SAID TRACT; THEN NORTH 74 DEGREES EAST ALONG THE NORTH LINE OF SAID TRACT 4.55 CHAINS TO AN IRON PIPE AT THE NORTHEAST CORNER OF SAID TRACT; THENCE SOUTH ALONG THE EAST LINE OF SAID TRACT 2.54 CHAINS, MORE OR LESS, TO THE PLACE OF BEGINNING.

MAP TRACED BY THE COUNTY SURVEYOR'S OFFICE, DALLAS, OREGON, OCTOBER 15, 1957.

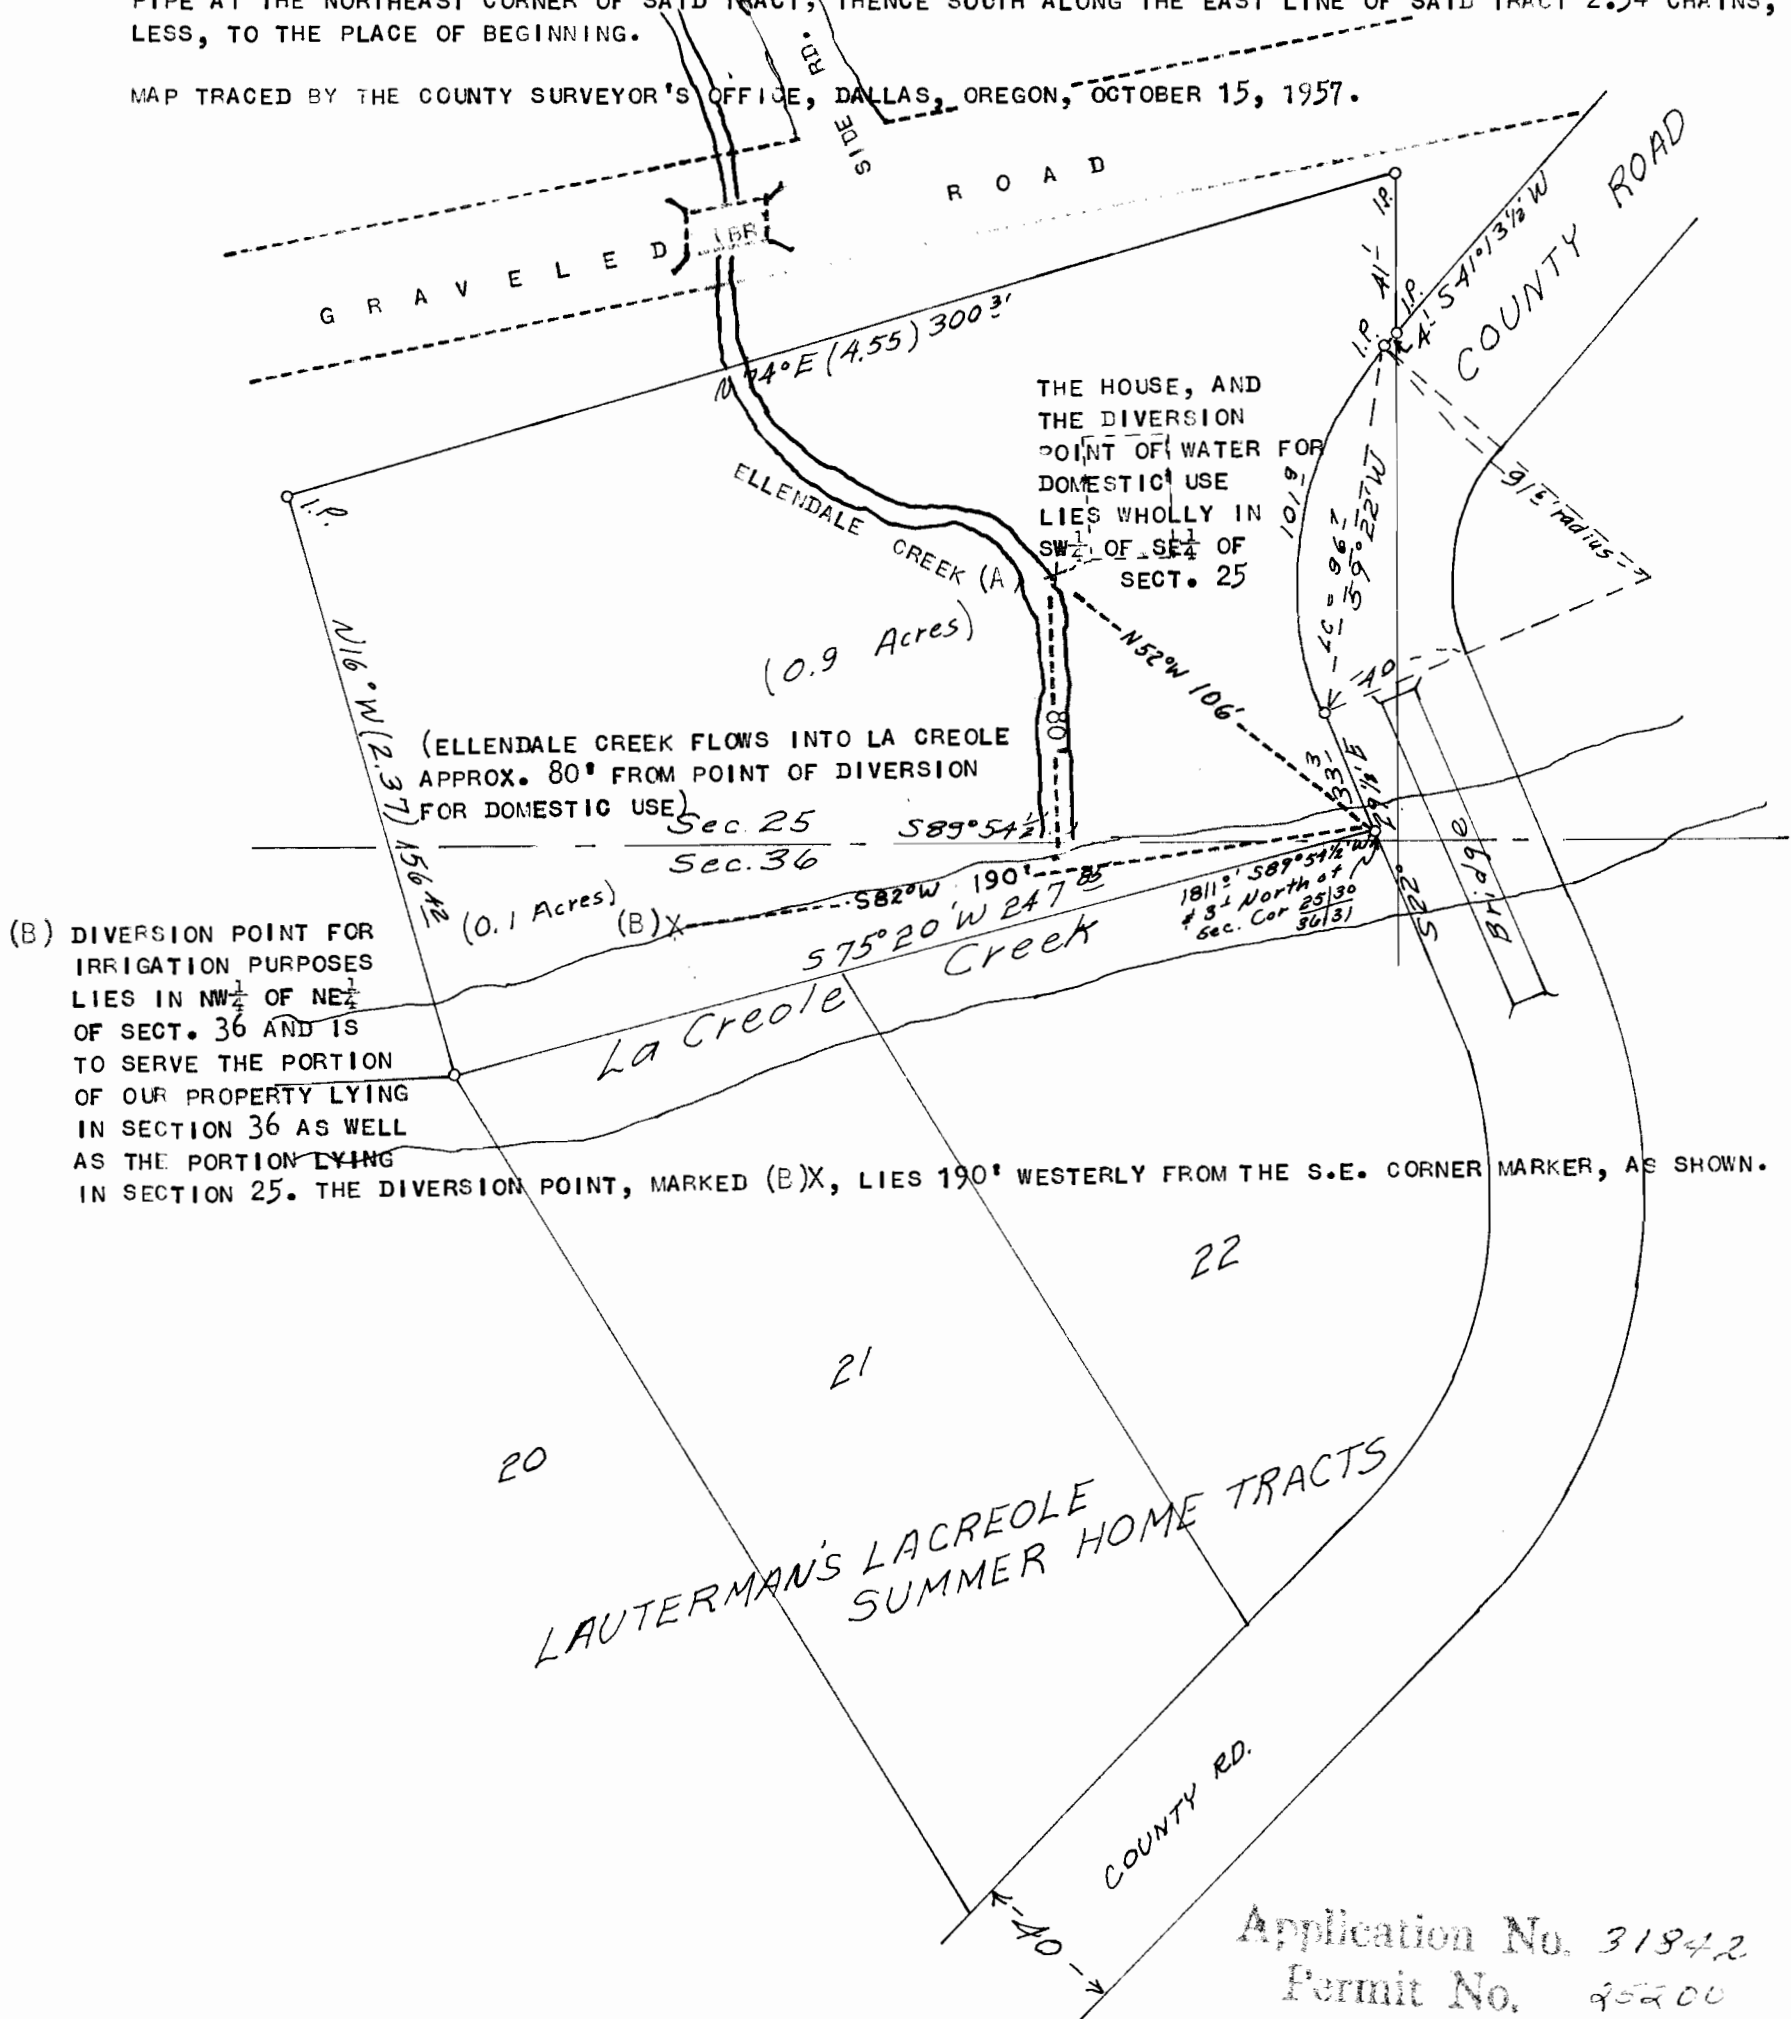

Application No. 31842  
Permit No. 95200